IREDELL COUNTY HEALTH DEPARTMENT

STATESVILLE 704-878-5305 MOORESVILLE 704-664-5281

IMPROVEMENT PERMIT / AUTHORIZATION TO CONSTRUCT / OPERATION PERMIT / EXISTING SYSTEM INSPECTION

PERMIT# 150995 PIN# 4772323201

OWNER OR APPLICANT CMH Homes DATE 6-11-08

ADDRESS Box 9796 Maryville TN 37801 PHONE: Business 865-380-3000 Home

LOCATION 115 Garden Ridge Dr (R) to (L) Ingraham Lot on Right About 2 miles

SUBDIVISION BLOCK / SECTION LOT 24 LOT AREA 1.188 SITE CLASS. V DESIGN FLOW 360 L.T.A.R. 3

Septic Tank: 1000 Gallons: STB Date

Pump Tank: Gallons: PT Date

Pump Make: Model Serial No.

Nitrification Field: No Fields Square Feet 1200 Linear Feet 300

No. Lines 4 Trench Width 36" Max Trench Bottom Depth 36"

☑ New System ☐ Repair ☐ Expansion System Type: I II III IV V VI

System Description: 25% Reduction

Repair System Description: 25% Pump

Maintenance Agreement Required: ☐ Yes ☐ No

Gravel Depth 12" ☑ Gravity ☐ Pressure

☑ House/Mod. Home No. Bedrooms 3

☐ Mobile Home No. Persons

☐ Business No. Employees

☐ Other

Water Supply: ☑ Individual ☐ Public ☐ Community

☐ Slab ☑ Crawl Space ☐ Basement w/plumbing ☐ Basement wo/plumbing

Comments:/Conditions:


Back of Single wide to be lined up with back of double wide next door

Comments:/Conditions:

Rock side walls

End Cap distribution

INITIAL SITE SKETCH

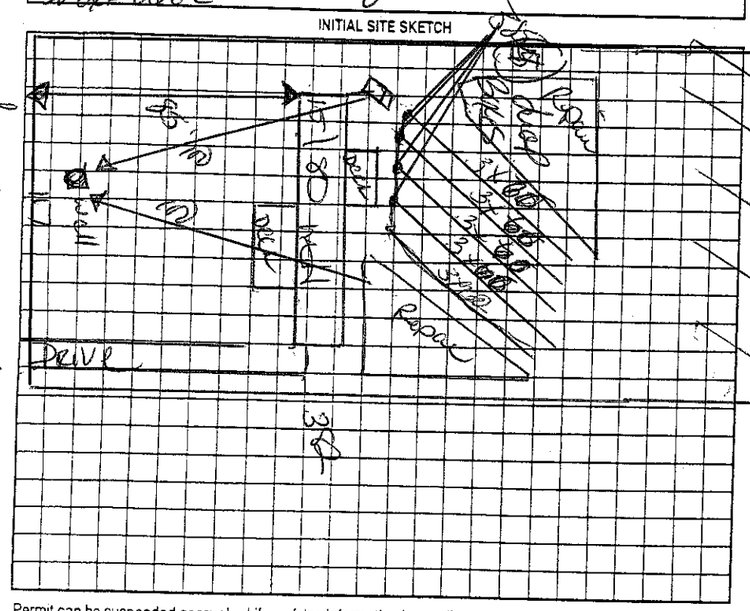

AS BUILT SKETCH



Permit can be suspended or revoked if any false information is supplied toward securing the permit/any unauthorized changes are made to the site/any unauthorized changes are made in the installation of the system. Improvement Permit with plat valid without expiration ☐ Improvement Permit with site plan valid for sixty months ☑ Authorization to Construct is valid for a period equal to that of Improvement Permit – not to exceed sixty months.

Signed: Dennis Dalliker date 6-11-08 Installed by: A Z Brashear

Improvement Permit by: Kelly Cox date 6-11-08 Operation Permit by: Kelly Cox date 6-23-08

Authorization to Construct by: Kelly Cox date 6-11-08 Existing System Inspection by: date

HEALTH DEPT. COPY: WHITE OWNER COPY (FINAL): YELLOW OWNER COPY (INITIAL): PINK