IREDELL COUNTY HEALTH DEPARTMENT

STATESVILLE 704-878-5305 MOORESVILLE 704-664-5281

IMPROVEMENT PERMIT / AUTHORIZATION TO CONSTRUCT / OPERATION PERMIT / EXISTING SYSTEM INSPECTION

PERMIT# 14993 PIN# 4772323303 DATE 3-28-08

OWNER OR APPLICANT [redacted] Joe Isaacs PHONE: Business 828-396-2150 Home

ADDRESS 3760 Big Horn Blvd Hudson NC 28638

LOCATION 70E to Leptell go past Complex 1/2 mile on right

SUBDIVISION BLOCK / SECTION LOT 1 LOT AREA 1.13 SITE CLASS B DESIGN FLOW 360 L.T.A.R. 125

Septic Tank: 1000 Gallons; STB Stump STB726 Date 11-11-07
Pump Tank: Gallons; PT Date
Pump Make: Model Serial No.
Nitrification Field: No Fields Square Feet 1440 Linear Feet 360
No Lines 5 Trench Width 36" Max Trench Bottom Depth 36 Gravel Depth

☑ New System ☐ Repair ☐ Expansion System Type: I II III IV V VI
System Description: 25% Gravity
Repair System Description: 25% Pump, 2
Maintenance Agreement Required: ☐ Yes ☐ No
☐ Gravity ☐ Pressure ☐ Slab ☑ Crawl Space ☐ Basement w/plumbing ☐ Basement wo/plumbing


☑ House/Mod. Home No. Bedrooms 3
☐ Mobile Home No. Persons
☐ Business No. Employees
☐ Other

Water Supply: ☑ Individual ☐ Public ☐ Community


Comments:/Conditions:
Use 36" Trench Bottom

Comments:/Conditions:
Poly lock fill
Rake Sidewalk
Maintain all setbacks
Install as Contour
Maintain 100 away from well
Remove Trench

INITIAL SITE SKETCH

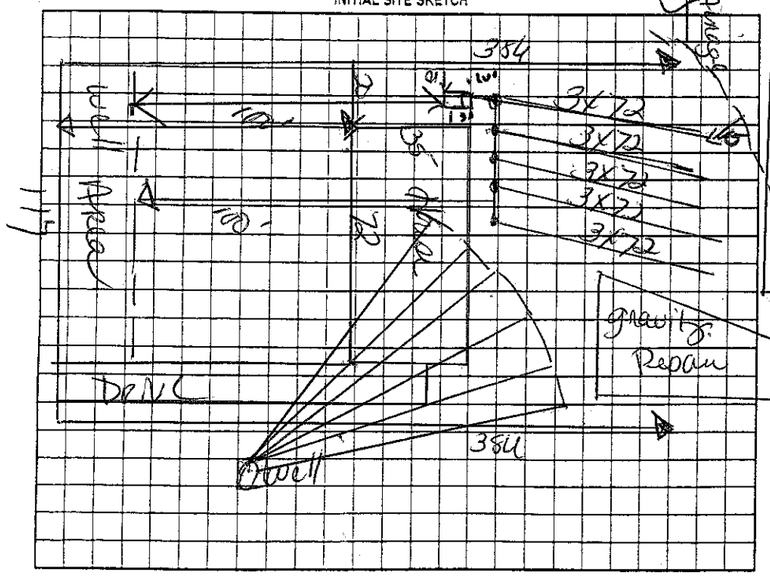

AS BUILT SKETCH

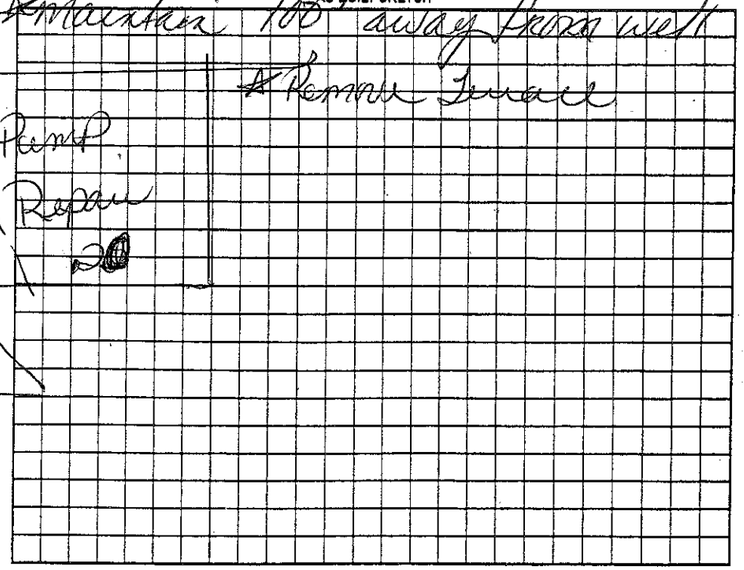

Permit can be suspended or revoked if any false information is supplied toward securing the permit/any unauthorized changes are made to the site/any unauthorized changes are made in the installation of the system. Improvement Permit with plat valid without expiration ☐ Improvement Permit with site plan valid for sixty months ☑ Authorization to Construct is valid for a period equal to that of Improvement Permit – not to exceed sixty months.

Signed: date 3-28-08

Improvement Permit by: date 3-28-08

Authorization to Construct by: date 3-28-08

Installed by: Knupp Grad. date

Operation Permit by: P.S. date 8 April 08

Existing System Inspection by: date

HEALTH DEPT. COPY: WHITE OWNER COPY (FINAL): YELLOW OWNER COPY (INITIAL): PINK