IREDELL COUNTY HEALTH DEPARTMENT - *ENVIRONMENTAL HEALTH* ☐ STATESVILLE OFFICE 704-878-5305 ☐ MOORESVILLE OFFICE 704-664-5281

IMPROVEMENT PERMIT / AUTHORIZATION TO CONSTRUCT // OPERATION PERMIT / EXISTING SYSTEM INSPECTION

PERMIT # 168906 PIN # 4772-41-5890 DATE 4 November 11

OWNER Rebecca Triplett APPLICANT Dennis's Home Pride PHONE: Home/Cell # (704) [redacted]746-7094 Business #

SITE ADDRESS 705 Triplette Rd. Cleveland OWNER / APPLICANT ADDRESS

SITE DIRECTIONS 70 E TR Triplette Rd 1 mile on left.

SUBDIVISION BLOCK / SECTION LOT # LOT AREA 5 Ac. DESIGN FLOW 360 gpd L.T.A.R. .02 gpd/ft²

Septic Tank 1000 Gallons: STB 1017 Date 4-7-11

Pump Tank Gallons: P T Date

Pump Make Model Serial #

No. Nitrification Fields: 1 No. Lines 5 Linear Feet 450

Trench Width 36" Max. Trench Bottom Depth 36" Gravel Depth NA

☑ New System ☐ Repair ☐ Expansion System Type I II (III) IV V VI

System Description: 25% Reduction

Repair System Description: 25% Reduction

Maintenance Agreement Required ☐ YES ☑ NO

☑ GRAVITY ☐ PRESSURE

☑ Residence No. Bedrooms 3

☐ Business No. Persons

☐ Other No. Employees


☐ Slab ☑ Crawl Space

☐ Basement w/plumbing ☐ Basement w/o plumbing

Water Supply: ☑ Private ☐ Public ☐ Community

Comments / Conditions

INITIAL SITE SKETCH

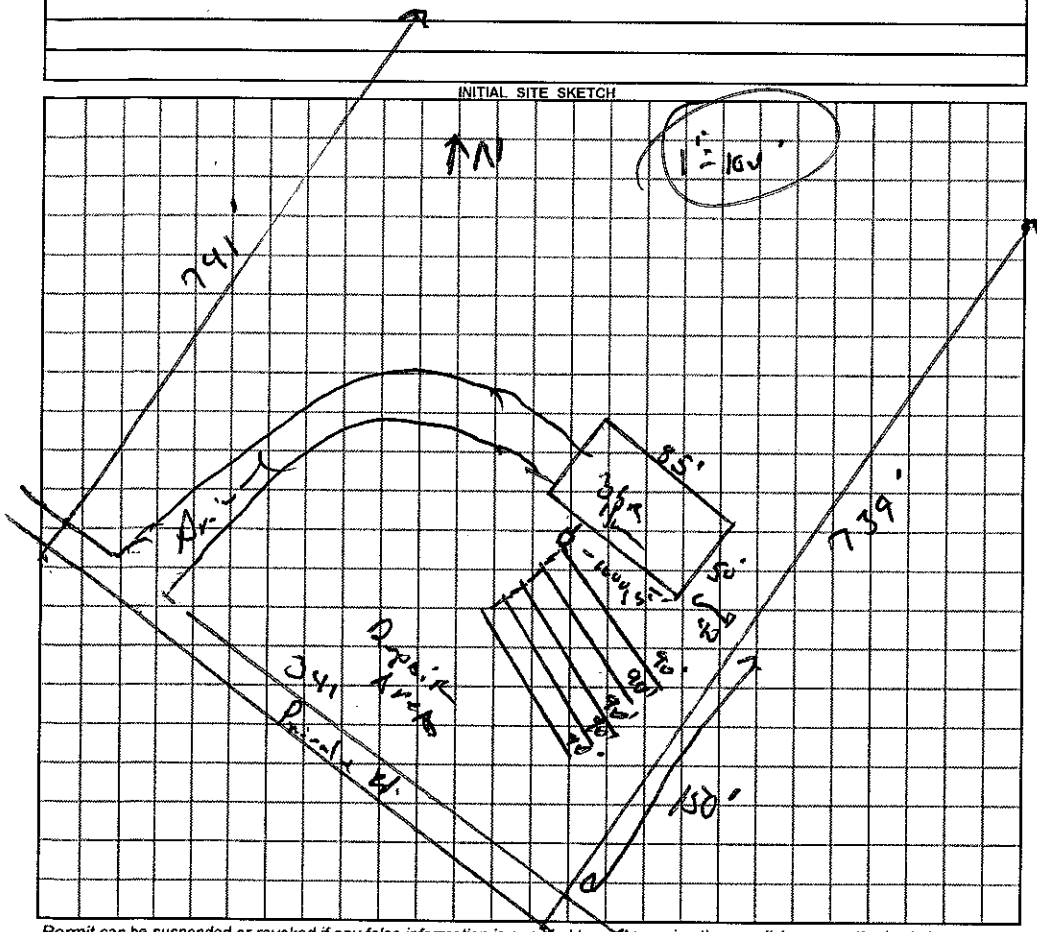

AS BUILT SKETCH

Permit can be suspended or revoked if any false information is supplied toward securing the permit / any unauthorized changes are made to the site / any unauthorized changes are made in the installation of the system.

☐ ***IMPROVEMENT PERMIT*** with plat valid without expiration. ☑ ***IMPROVEMENT PERMIT*** with plat valid without expiration. site plan valid 60 mo. ☑ ***AUTHORIZATION TO CONSTRUCT*** valid for period equal to IMPROVEMENT PERMIT--not to exceed 60 mo.

Owner / Applicant Signature: Date 11/8/11 Installed by: Groundbreakers

IMPROVEMENT PERMIT by: REHS Date 7 Nov. 11 OPERATION PERMIT by: REHS Date 11-28-11

AUTHORIZATION TO CONSTRUCT by: REHS Date 7 Nov. 11 Existing System Inspected by: REHS Date

YOU SHOULD CONTACT A LOCATOR SERVICE PRIOR TO ANY EXCAVATION

White Copy – Environmental Health YELLOW COPY (Final) Owner / Applicant PINK COPY (Initial) Owner / Applicant