Original paperwork !!!!

IREDELL COUNTY HEALTH DEPARTMENT - *ENVIRONMENTAL HEALTH* ☐ STATESVILLE OFFICE 704-878-5305 ☐ MOORESVILLE OFFICE 704-664-5281

IMPROVEMENT PERMIT / AUTHORIZATION TO CONSTRUCT / OPERATION PERMIT / EXISTING SYSTEM INSPECTION

PERMIT # 16890[illegible] PIN # 4772-47-5890 DATE 4 November 11

OWNER Rebecca Hewitt APPLICANT Brandi Hall PHONE: Home/Cell # (704) 798-7054 Business #

SITE ADDRESS 905 Twaddle Rd. Statesville OWNER / APPLICANT ADDRESS

SITE DIRECTIONS 70 E TR Twaddle Rd 1 mile on left.

SUBDIVISION BLOCK / SECTION LOT # LOT AREA 5 Ac. DESIGN FLOW 360 gpd L.T.A.R. 0.2 / 1440

Septic Tank 1000 Gallons: STB 1017 Date 4-7-11

Pump Tank Gallons: PT 1 Date

Pump Make Model Serial #

No. Nitrification Fields: 1 No. Lines 5 Linear Feet 450

Trench Width 36" Max. Trench Bottom Depth 36" Gravel Depth N/A

☑ New System ☐ Repair ☐ Expansion System Type I II III IV V VI

System Description: 25% Reduction

Repair System Description: 25% Reduction

Maintenance Agreement Required ☐ YES ☑ NO

☑ GRAVITY ☐ PRESSURE

☑ Residence No. Bedrooms 3

☐ Business No. Persons

☐ Other No. Employees


☐ Slab ☑ Crawl Space

☐ Basement w/plumbing ☐ Basement w/o plumbing


Water Supply: ☑ Private ☐ Public ☐ Community

Comments / Conditions

INITIAL SITE SKETCH

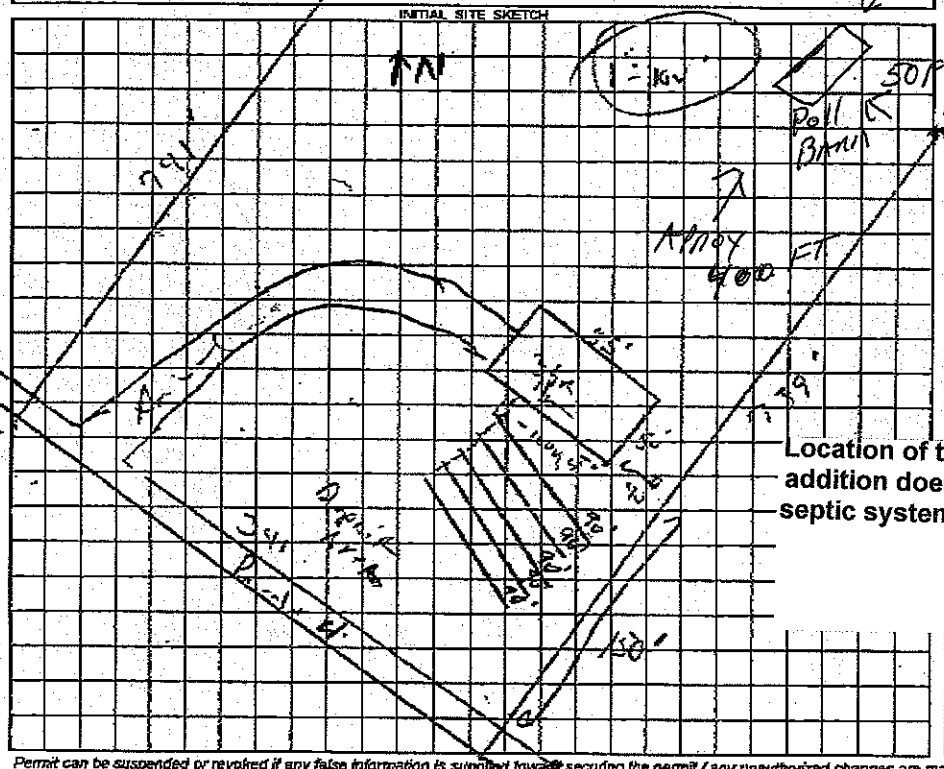

AS BUILT SKETCH

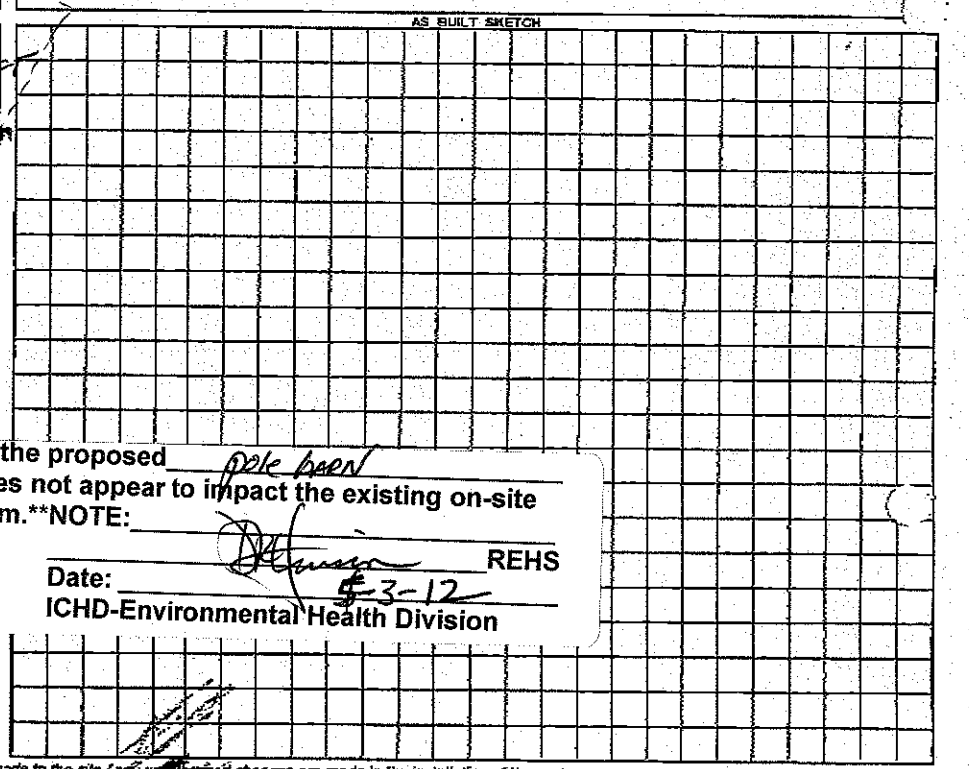

Location of the proposed pole barn addition does not appear to impact the existing on-site septic system.**NOTE:

REHS

Date: 4-3-12

ICHD-Environmental Health Division

Permit can be suspended or revoked if any false information is supplied toward securing the permit / any unauthorized changes are made to the site / any unauthorized changes are made in the installation of the system.

☐ *IMPROVEMENT PERMIT* with plat valid without expiration. ☑ *IMPROVEMENT PERMIT* with plat valid without expiration, site plan valid 60 mos. ☑ *AUTHORIZATION TO CONSTRUCT* valid for period equal to IMPROVEMENT PERMIT—not to exceed 60 mo.

Owner / Applicant Signature: Date 11/8/11 Installed by: Groundbreakers

IMPROVEMENT PERMIT by: REHS Date Nov. 11 OPERATION PERMIT by: REHS Date 11-28-11

AUTHORIZATION TO CONSTRUCT by: REHS Date Existing System Inspected by: REHS Date

No. 3762 P. 2

Jan. 3. 2012 11:27AM Milner