IREDELL COUNTY HEALTH DEPARTMENT - *ENVIRONMENTAL HEALTH* ☐ STATESVILLE OFFICE 704-878-5305 ☐ MOORESVILLE OFFICE 704-664-5281

IMPROVEMENT PERMIT / AUTHORIZATION TO CONSTRUCT / OPERATION PERMIT / EXISTING SYSTEM INSPECTION

PERMIT # 168168 PIN # 4772-48-0167 DATE 26 August 2011

OWNER Bruce Faust APPLICANT:

SITE ADDRESS 381 Triplett Rd. Cleveland, NC OWNER / APPLICANT ADDRESS PHONE: Home/Cell # (704)-239-3693 Business #

SITE DIRECTIONS Hwy 70 E TR Triplett Rd. Single-wide mobile home on left before Cornflower Rd.

SUBDIVISION BLOCK / SECTION LOT # LOT AREA 5.7 ac. DESIGN FLOW 360 gpd L.T.A.R. exist.

Septic Tank 1500 Gallons: STB Date

Pump Tank Gallons: P T Date

Pump Make Model Serial #

No. Nitrification Fields: 1 No. Lines 2 Linear Feet 500

Trench Width 2.5 ft. Max. Trench Bottom Depth exist. Gravel Depth exist.

☐ New System ☐ Repair ☐ Expansion System Type I (II) III IV V VI

System Description: Gravel bed

Repair System Description:

Maintenance Agreement Required ☐ YES ☒ NO

☐ GRAVITY ☐ PRESSURE

☑ Residence No. Bedrooms 3

☐ Business No. Persons

☐ Other No. Employees

☐ Slab ☑ Crawl Space


☐ Basement w/plumbing ☐ Basement w/o plumbing

Water Supply: ☑ Private ☐ Public ☐ Community

Comments / Conditions

INITIAL SITE SKETCH

AS BUILT SKETCH

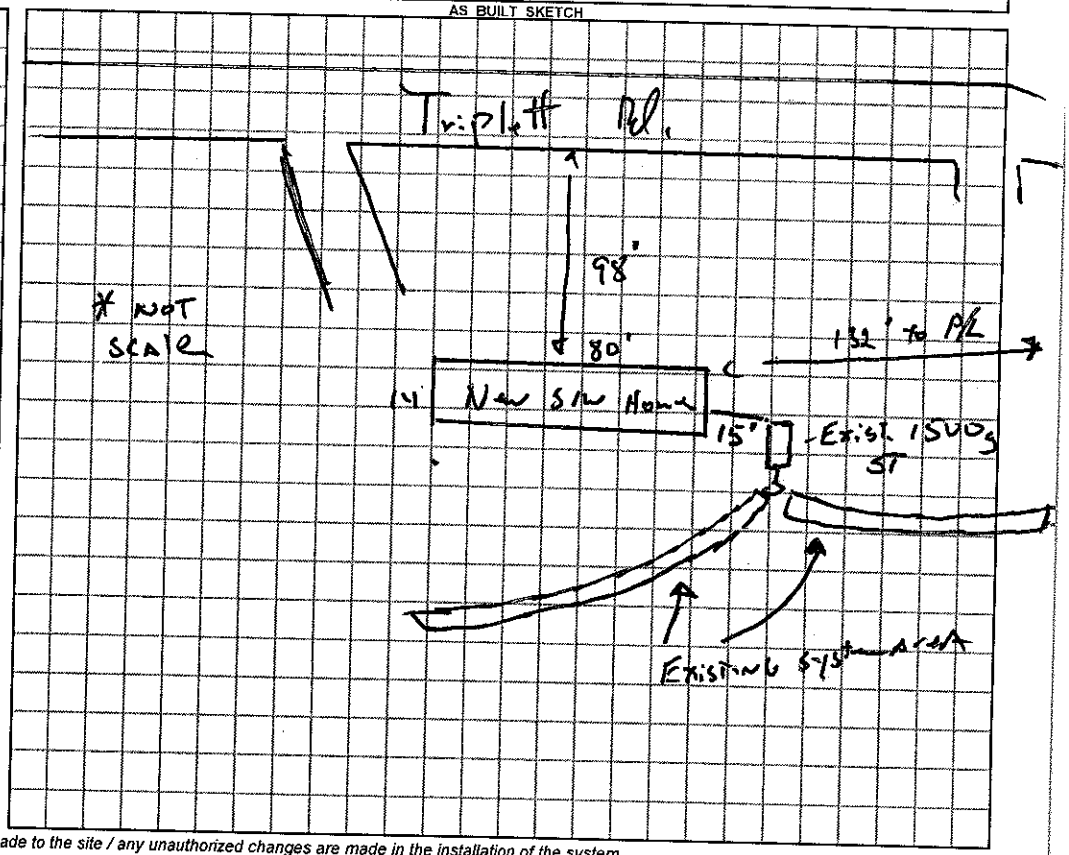

Permit can be suspended or revoked if any false information is supplied toward securing the permit / any unauthorized changes are made to the site / any unauthorized changes are made in the installation of the system.

☐ ***IMPROVEMENT PERMIT*** with plat valid without expiration. ☐ ***IMPROVEMENT PERMIT*** with ~~plat valid without expiration.~~ site plan valid 60 mo. ☐ ***AUTHORIZATION TO CONSTRUCT*** valid for period equal to IMPROVEMENT PERMIT--not to exceed 60 mo.

Owner / Applicant Signature: Deena Shee Date 8/2/11

IMPROVEMENT PERMIT by: REHS Date

AUTHORIZATION TO CONSTRUCT by: REHS Date

YOU SHOULD CONTACT A LOCATOR SERVICE PRIOR TO ANY EXCAVATION

Installed by:

OPERATION PERMIT by: REHS Date

Existing System Inspected by: REHS Date 26 Aug. 11

White Copy – Environmental Health YELLOW COPY (FOR) Owner / Applicant PINK COPY (Initial) Owner / Applicant