IREDELL COUNTY HEALTH DEPARTMENT

STATESVILLE 704-878-5305 MOORESVILLE 704-664-5281

IMPROVEMENT PERMIT / CERTIFICATE OF COMPLETION / OPERATION PERMIT / EXISTING SYSTEM INSPECTION

PROPERTY DESCRIPTION NO. ~~23183~~ 061990 DATE 3-21-96 TAX MAP NO. 5J - A-30 Watershed: ☐ Yes ☑ No

OWNER OR CONTRACTOR Larry Isenhour PHONE Business Home 872 7086

ADDRESS 363 Triplett Rd Cleveland, N.C.

LOCATION Hwy 70 E TR Triplett 1 mile on left

SUBDIVISION BLOCK / SECTION LOT LOT AREA 7.2 acres SITE CLASS PS DESIGN FLOW 360 L.T.A.R. .3

Septic Tank: 1000 Gallons: STB 760 Date 3-8-97

Pump Tank: Gallons: PT Date

Pump Make: Model Serial No

Nitrification Field: No Fields 1 Square Feet 1200 Linear Feet 400

No Lines 5 Trench Width 36" Max Trench Bottom Depth 36" Gravel Depth 12"

☐ New System ☐ Repair System Type: I II III IV V VI

System Description: Conv. Gravity

Repair System Description: " "

Maintenance Agreement Required: Yes ~~No~~

☐ House/Mod. Home ☐ Mobile Home ☐ Business ☐ Other

No. Bedrooms 3 No. Bathrooms 2 No. Employees


☐ Slab ☐ Crawl Space ☐ Basement w/plumbing ☐ Basement wo/plumbing

Water Supply: ☐ Individual ☐ Community ☐ Public


Comments:

Comments:

INITIAL SITE SKETCH

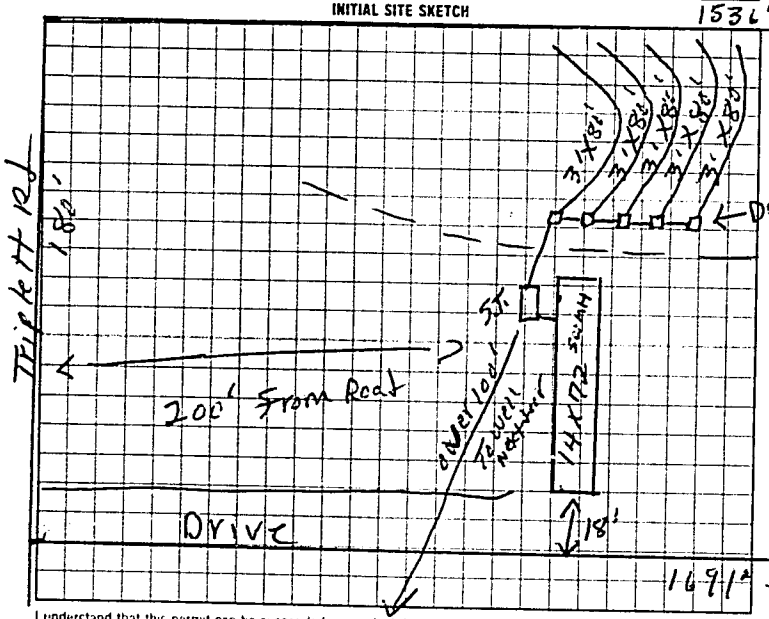

AS BUILT SKETCH

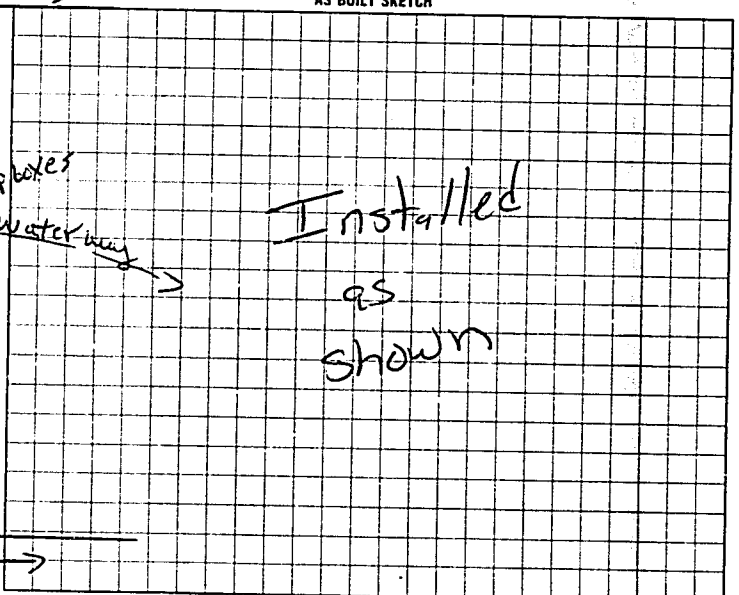

I understand that this permit can be suspended or revoked if any false information is supplied toward securing the permit/any unauthorized changes are made to the site/any unauthorized changes are made in the installation of the system

Signed X Larry Isenhour

Improvement Permit by L.C. Moore date 3-21-96

Existing System Inspection by L.C. Moore date 3-21-96

Installed by Wayne Potts

Certificate of Completion by date

Operation Permit by Mat Coy RS date 5-8-97

authorization to Count Expires 60 mos from issue

to count IN WITH DEPT COPY WHITE INSPECTION COPY (INITIAL) GREEN OWNER COPY (INITIAL) YELLOW INSPECTION COPY (INITIAL) PINK OWNER COPY (INITIAL) GOLD