IREDELL COUNTY HEALTH DEPARTMENT

STATESVILLE 704-878-5305 MOORESVILLE 704-664-5281

IMPROVEMENT PERMIT / CERTIFICATE OF COMPLETION / OPERATION PERMIT / EXISTING SYSTEM INSPECTION

PROPERTY DESCRIPTION NO. 66677 DATE 5-29-97 TAX MAP NO. 4773524436

OWNER OR CONTRACTOR M.R. Brown PHONE: Business Watershed: ☐ Yes ☐ No

ADDRESS 150 Triplett Rd Cleveland N.C. Home 872 9654

LOCATION 705 TR Triplett Rd 3/4mi on Rt

SUBDIVISION BLOCK / SECTION LOT LOT AREA 20,625sq SITE CLASS. PS DESIGN FLOW 360 L.T.A.R. .3

Septic Tank: Gallons: STB 1012 Date 4-21-97

Pump Tank: Gallons; PT Date

Pump Make: Model Serial No.

Nitrification Field: No Fields 1 Square Feet 960 Linear Feet 300

No Lines 5 Trench Width 36" Max Trench Bottom Depth 36" Gravel Depth N/A

☐ New System ☐ Repair System Type: I, II, III, IV, V, VI

System Description: Gravity/chambers

Repair System Description: "

Maintenance Agreement Required: ☐ Yes ☐ No

☐ House/Mod. Home No. Bedrooms 3

☑ Mobile Home No. Bathrooms 2

☐ Business No. Employees

☐ Other


☐ Slab ☐ Crawl Space ☐ Basement w/plumbing ☐ Basement wo/plumbing

Water Supply: ☒ Individual ☐ Community ☐ Public


Comments:

Comments:

INITIAL SITE SKETCH

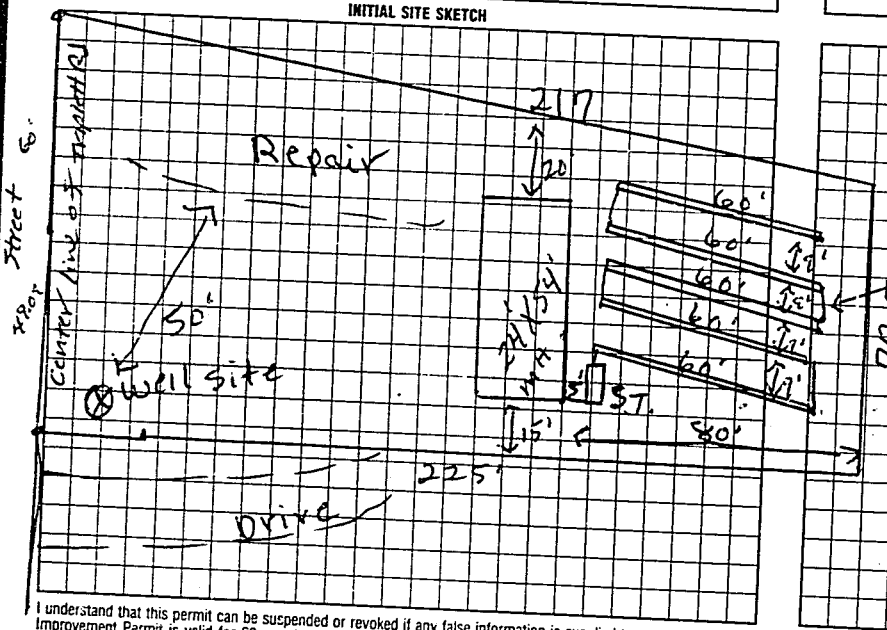

AS BUILT SKETCH

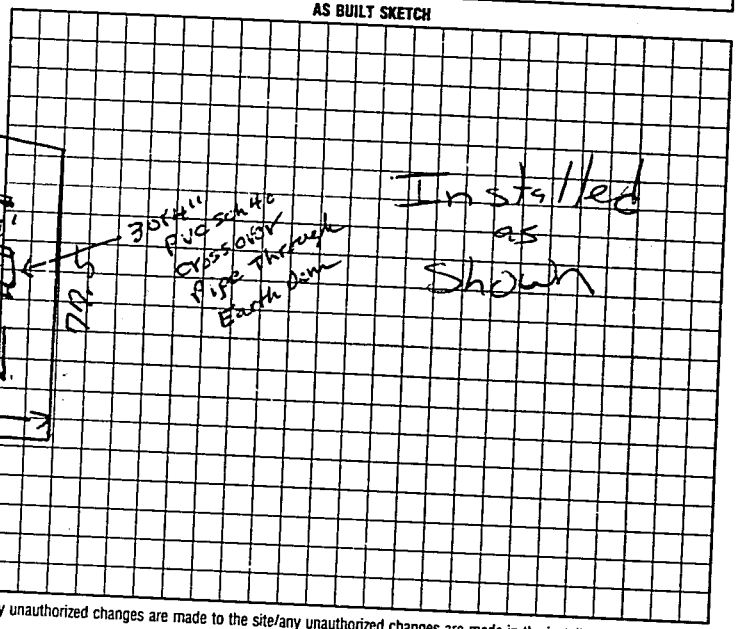

I understand that this permit can be suspended or revoked if any false information is supplied toward securing the permit/any unauthorized changes are made to the site/any unauthorized changes are made in the installation of the system. Improvement Permit is valid for 60 months from date of issuance.

Signed:

Improvement Permit by: E. Moore date 5-29-97

Authorization Existing System Inspection by: E. Moore date 5-29-97

Installed by: A-1

Certificate of Completion by:

Operation Permit by: Mark C. Outlaw date 6-17-97

HEALTH DEPT. COPY: WHITE INSPECTION COPY (FINAL): GREEN OWNER COPY (FINAL): YELLOW INSPECTION COPY (INITIAL): PINK OWNER COPY (INITIAL): BLUE

to come. Authorization to come Expires 60 mos from issue