IREDELL COUNTY HEALTH DEPARTMENT

STATESVILLE 704-878-5305 MOORESVILLE 704-664-5281

IMPROVEMENT PERMIT / AUTHORIZATION TO CONSTRUCT / OPERATION PERMIT / EXISTING SYSTEM INSPECTION

PERMIT# 90032 PIN# 4773 50 1149 pT DATE June 28-2000

OWNER OR CONTRACTOR Ray Benge PHONE: Business 873 2547 Home

ADDRESS 1214 Island Ford Rd Statesville

LOCATION Hwy 70 E (R) Triplett (R) Browns Farm 3rd on Left From Corner

SUBDIVISION Browns Farm BLOCK / SECTION LOT 13 LOT AREA .54 SITE CLASS PS DESIGN FLOW 360 L.T.A.R. .3

Septic Tank: 1000 Gallons: STB Date 4 23 00
Pump Tank: Gallons: PT Date
Pump Make: Model Serial No.
Nitrification Field: No Fields 1 Square Feet 120 Linear Feet 400
No Lines 4 Trench Width 36" Max Trench Bottom Depth 36-40" Gravel Depth 12"

☑ New System ☐ Repair System Type: I II III IV V VI
System Description: Conventional Gravity
Repair System Description: Reduction Pump Possible
Maintenance Agreement Required: ☐ Yes ☑ No

☐ House/Mod. Home No. Bedrooms 3
☑ Mobile Home No. Bathrooms 2
☐ Business No. Employees
☐ Other


☐ Slab ☑ Crawl Space ☐ Basement w/plumbing ☐ Basement wo/plumbing

Water Supply: ☑ Individual ☐ Public ☐ Community
well

Comments:/Conditions:


PL 74'

NOT TO SCALE REPAIR INITIAL SITE SKETCH

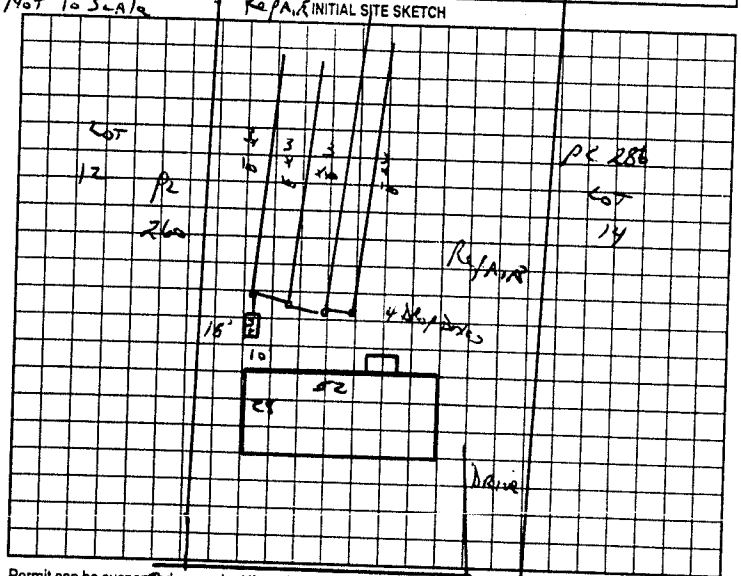

Comments:/Conditions.

AS BUILT SKETCH

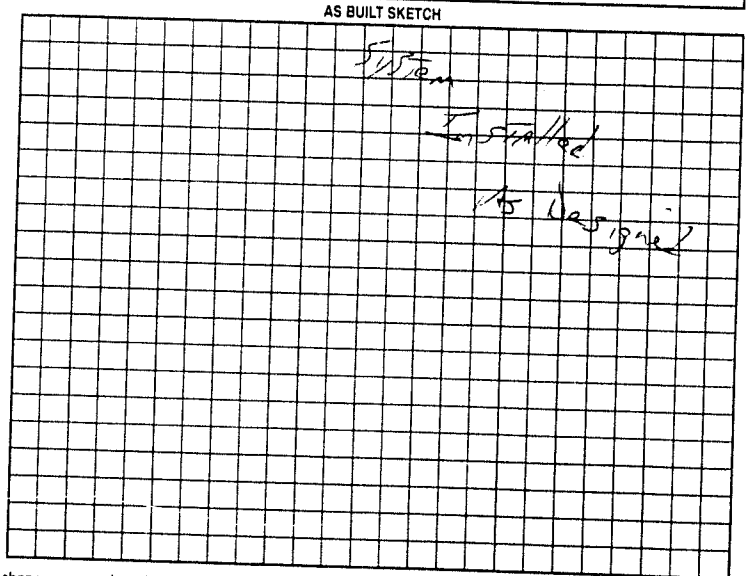

Permit can be suspended or revoked if any false information is supplied toward securing the permit/any unauthorized changes are made to the site/any unauthorized changes are made in the installation of the system. Improvement Permit with plat valid without expiration. Improvement Permit with site plan valid for sixty months. Authorization to Construct is valid for a period equal to that of Improvement Permit – not to exceed sixty months.

Signed: date 6-28-00 Installed by: Craig Thompson

Improvement Permit by: L Potter date June 28 2000 Operation Permit by: L Potter date 11/7/22

Authorization to Construct by: L Potter date June 28 2000 Existing System Inspection by: date

HEALTH DEPT. COPY. WHITE OWNER COPY (FINAL) YELLOW OWNER COPY (INITIAL) PINK