IREDELL COUNTY HEALTH DEPARTMENT

STATESVILLE 704-878-5305 MOORESVILLE 704-664-5281

IMPROVEMENT PERMIT / AUTHORIZATION TO CONSTRUCT / OPERATION PERMIT / EXISTING SYSTEM INSPECTION

PERMIT# 8898 PIN# 4773501149 PT DATE May 15 2000

OWNER OR CONTRACTOR Kimberly Rowe PHONE: Business Home

ADDRESS 155 Bluegill Ln Statesville NC 28625

LOCATION Hwy 70 E (R) Triplett (R) 1113 Browns Farm 2nd Lot on Left

SUBDIVISION Brown Farm BLOCK / SECTION LOT 12 LOT AREA .55 SITE CLASS PS DESIGN FLOW 360 L.T.A.R. > 3

Septic Tank: 1000 Gallons: STB 312 Date 4-8-00
Pump Tank: Gallons: PT Date
Pump Make: Model Serial No.
Nitrification Field: No Fields 1 Square Feet 1200 Linear Feet 400
No Lines 4 Trench Width 36" Max Trench Bottom Depth 36" Gravel Depth 12"

☒ New System ☐ Repair System Type: I (II) III. IV. V. VI
System Description: Conv. GRAVITY
Repair System Description: Same Possible Reduction
Maintenance Agreement Required: ☐ Yes ☒ No
☐ Slab ☒ Crawl Space ☐ Basement w/plumbing ☐ Basement wo/plumbing


☐ House/Mod. Home No. Bedrooms 3
☒ Mobile Home 1 W No. Rathrooms 2
☐ Business No. Employees
☐ Other

Water Supply: ☒ Individual ☐ Public ☐ Community WELL

Comments:/Conditions: INSTALL on CONTOUR
LOCATE well 100ft OR MAX Feasible distance
NOT TO SCALE

Comments:/Conditions: From septic system

INITIAL SITE SKETCH

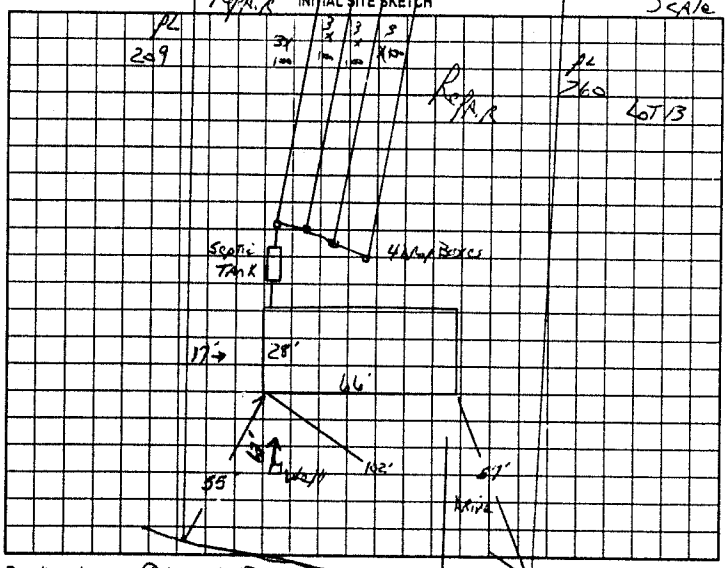

AS BUILT SKETCH

Installed as shown

Permit can be suspended or revoked if any false information is supplied toward securing the permit/any unauthorized changes are made to the site/any unauthorized changes are made in the installation of the system. Improvement Permit with plat valid without expiration. Improvement Permit with site plan valid for sixty months. Authorization to Construct is valid for a period equal to that of Improvement Permit – not to exceed sixty months.

Signed: Ralph E. Colyer Jr. date Installed by: Craig Thompson

Improvement Permit by: Joe Potter date May 15 2000 Operation Permit by: [signature] date 5.23.00

Authorization to Construct by: Joe Potter date May 15 2000 Existing System Inspection by: date

HEALTH DEPT. COPY: WHITE OWNER COPY (FINAL): YELLOW OWNER COPY (INITIAL): PINK