11:30

IREDELL COUNTY HEALTH DEPARTMENT

STATESVILLE 704-878-5305 MOORESVILLE 704-664-5281

IMPROVEMENT PERMIT / AUTHORIZATION TO CONSTRUCT / OPERATION PERMIT / EXISTING SYSTEM INSPECTION

PERMIT# 78590 PIN# 4773 50 1149 DATE 1-8-99

OWNER OR CONTRACTOR Lydia Wyles PHONE: Business 873 2547 Home

ADDRESS 300 Triplett Rd

LOCATION 70E TR Triplett Rd 1/2 mi on Rt.

SUBDIVISION J.R. Brown Fm BLOCK / SECTION LOT #3 LOT AREA .45 acres SITE CLASS PS DESIGN FLOW 360 L.T.A.R. .3

Septic Tank: 1000 Gallons; STB 1012 Date 2-3-99

Pump Tank: Gallons; PT Date

Pump Make: Model Serial No

Nitrification Field: No Fields 1 Square Feet 900 Linear Feet 300

No Lines 5 Trench Width 36" Max Trench Bottom Depth 36" Gravel Depth N/A

~~New System~~ Repair System Type: I, II, III, IV, V, VI

System Description Gravity/25% Red

Repair System Description I II III

Maintenance Agreement Required: Yes ~~No~~

~~House/Mod. Home~~ No. Bedrooms 3

~~Mobile Home~~ No. Bathrooms 2

Business No. Employees

Other

Slab ~~Crawl Space~~ Basement w/plumbing Basement wo/plumbing


Water Supply: ~~Individual~~ Public Community

Comments/Conditions:


Comments/Conditions

owner bought next lot

INITIAL SITE SKETCH

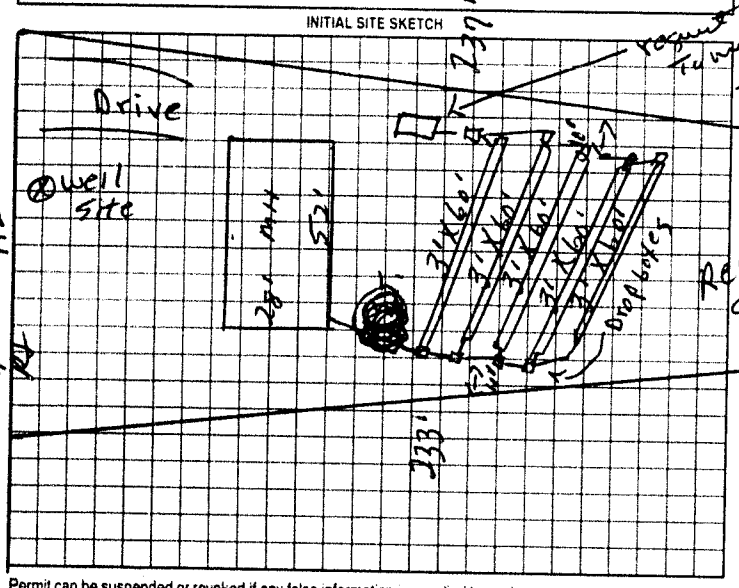

AS BUILT SKETCH

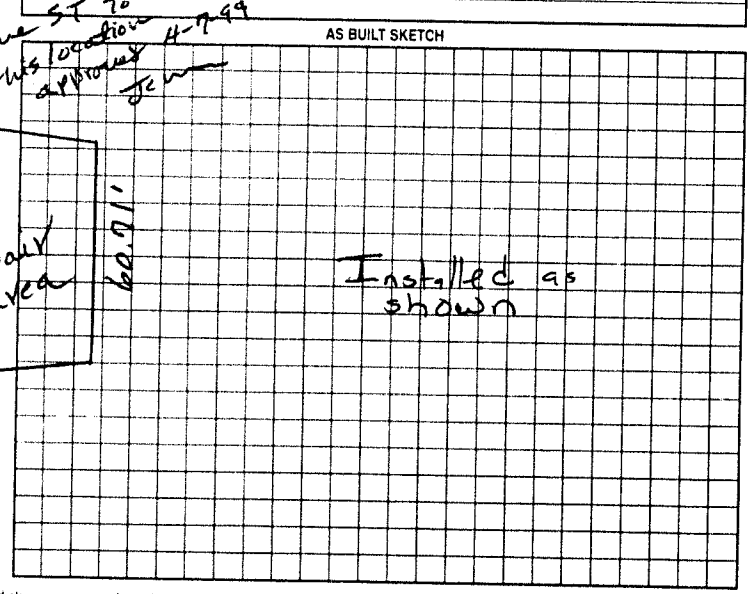

Permit can be suspended or revoked if any false information is supplied toward securing the permit/any unauthorized changes are made to the site/any unauthorized changes are made in the installation of the system. Improvement Permit with plat valid without expiration. Improvement Permit with site plan valid for sixty months. Authorization to Construct is valid for a period equal to that of Improvement Permit – not to exceed sixty months.

Signed Lydia Wyles date 1/13/99

Improvement Permit by: P. S. Moore date 1-8-99

Authorization to Construct by: P. C. Moore date 1-8-99

Installed by: A-1 Backhoe

Operation Permit by: Mat Cox RS date 4-7-99

Existing System Inspection by: date

HEALTH DEPT COPY WHITE OWNER COPY (FINAL) YELLOW OWNER COPY (INITIAL) PINK