IREDELL COUNTY HEALTH DEPARTMENT

STATESVILLE 704-878-5305 MOORESVILLE 704-664-5281

IMPROVEMENT PERMIT / AUTHORIZATION TO CONSTRUCT / OPERATION PERMIT / EXISTING SYSTEM INSPECTION

PERMIT# 74637 PIN# 4773 88 2657 DATE 6-20-98

OWNER OR CONTRACTOR Acorn Development PHONE: Business 872 0072 Home

ADDRESS 517 Stinson Ct. Statesville

LOCATION 70 East TR Knox Emmet TR Sage Lane last lot left

SUBDIVISION Crestfield BLOCK / SECTION II LOT 16 LOT AREA 22094 SITE CLASS. PS DESIGN FLOW 360 L.T.A.R. .3

Septic Tank: 1000 Gallons; STB 1012 Date 9-9-98

Pump Tank: Gallons; PT Date

Pump Make: Model Serial No.

Nitrification Field: No Fields 1 Square Feet 900 Linear Feet 300

No Lines 3 Trench Width 36" Max Trench Bottom Depth 36" Gravel Depth N/A

☑ New System ☐ Repair System Type: I, II, III, IV, V, VI

System Description: 25% Reduction System

Repair System Description:

Maintenance Agreement Required: ☐ Yes ☑ No

☐ House/Mod. Home No. Bedrooms 3

☑ Mobile Home No. Bathrooms 2

☐ Business No. Employees

☐ Other


☐ Slab ☑ Crawl Space ☐ Basement w/plumbing ☐ Basement wo/plumbing

Water Supply: ☑ Individual ☐ Public ☐ Community

Comments:/Conditions:

Comments:/Conditions:

INITIAL SITE SKETCH

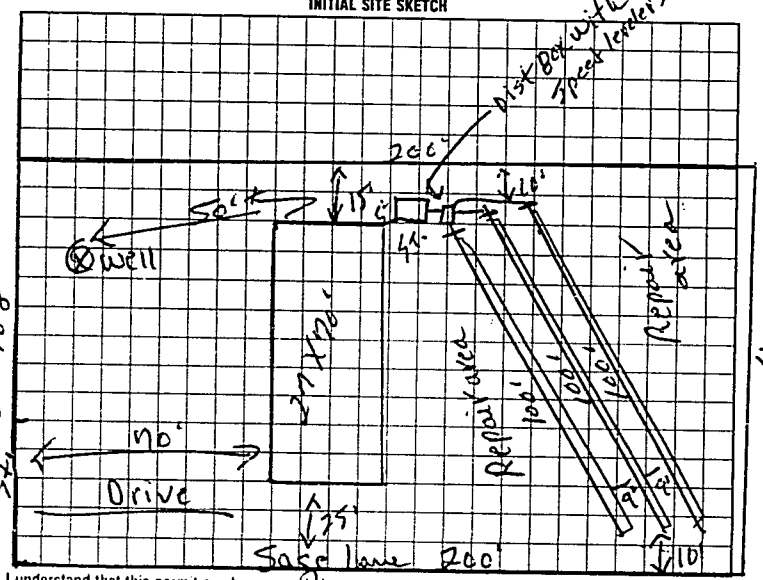

AS BUILT SKETCH

Same as initial Sketch

I understand that this permit can be suspended or revoked if any false information is supplied toward securing the permit/any unauthorized changes are made to the site/any unauthorized changes are made in the installation of the system. Improvement Permit with plat valid without expiration. Improvement Permit with site plan valid for sixty months. Authorization to Construct is valid for a period equal to that of Improvement Permit – not to exceed sixty months.

Signed: Thomas J White date 7-21-95

Improvement Permit by: L. C. Moore date 6-20-98

Authorization to Construct by L. C. Moore date 6-20-98

HEALTH DEPT COPY (WHITE) PROPERTY OWNER COPY (FINAL) GREEN

Installed by: A-1 Backhoe

Operation Permit by: L. C. Moore date 11-16-98

Existing System Inspection by date

OWNER COPY (FINAL) YELLOW INSPECTION COPY (INITIAL) PINK