IREDELL COUNTY HEALTH DEPARTMENT

STATESVILLE 704-878-5305 MOORESVILLE 704-664-5281

IMPROVEMENT PERMIT / CERTIFICATE OF COMPLETION / OPERATION PERMIT / EXISTING SYSTEM INSPECTION

PROPERTY DESCRIPTION NO. 24746/87326 DATE 9-5-96 TAX MAP NO. 5H-1-A-11 Watershed: ☐ Yes ☐ No

OWNER OR CONTRACTOR Myrtle Keller PHONE: Business Home 704 872 3405

ADDRESS 253 Triplett Rd Cleveland N.C.

LOCATION 70 E TR Knox Fm Rd before creek on rt

SUBDIVISION H.G. upright BLOCK / SECTION LOT 11 LOT AREA 5 acres SITE CLASS PS DESIGN FLOW 360 L.T.A.R. .12

Septic Tank: 1000 Gallons; STB 825 Date 12-4-99
Pump Tank: Gallons; PT Date
Pump Make: Model Serial No.
Nitrification Field: No Fields 1 Square Feet 1800 Linear Feet 600
No Lines 4 Trench Width 36" Max Trench Bottom Depth 18" Gravel Depth 12"

☑ New System ☐ Repair System Type: I. II. III. IV. V. VI
System Description: Shallow Placed Conv.
Repair System Description: LPP
Maintenance Agreement Required: ☐ Yes ☑ No


☐ House/Mod. Home No. Bedrooms 3
☑ Mobile Home No. Bathrooms 2
☐ Business No. Employees
☐ Other
☐ Slab ☑ Crawl Space ☐ Basement w/plumbing ☐ Basement wo/plumbing

Water Supply: ☑ Individual ☐ Community ☐ Public


Comments:
Very Important To Get System Shallow No deeper than 18" Ditches Backfill with Top soil No Clay

Comments:

INITIAL SITE SKETCH

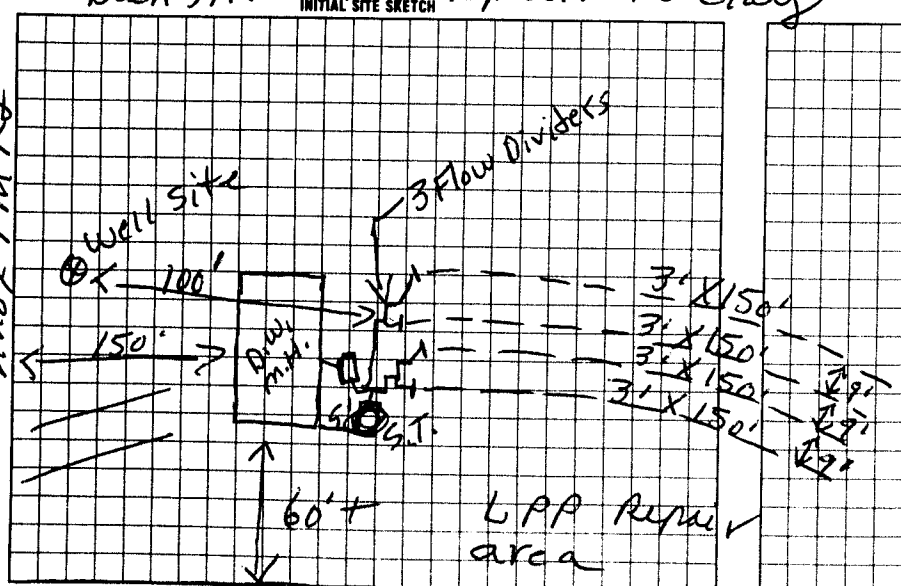

AS BUILT SKETCH

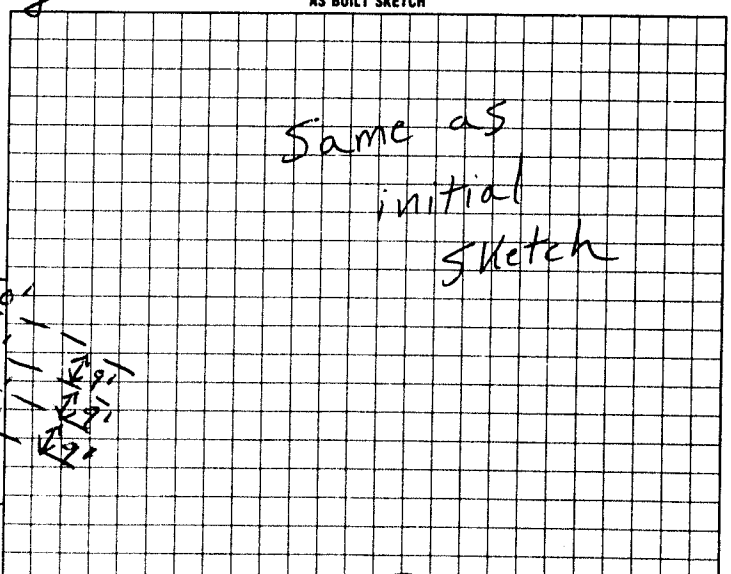

I understand that this permit can be suspended or revoked if any false information is supplied toward securing the permit/any unauthorized changes are made to the site/any unauthorized changes are made in the installation of the system.

Signed: Myrtle W Keller

Improvement Permit by: L.C. Moore date 9-5-96

Authorization to Install Existing System Inspection by: L.C. Moore date 9-5-96

Installed by Piedmont S.T. Co.

Certificate of Completion by date

Operation Permit by L.C. Moore date 2-7-00

HEALTH DEPT COPY WHITE — INSPECTION COPY (FINAL) GREEN — OWNER COPY (FINAL) YELLOW — INSPECTION COPY (INITIAL) PINK — OWNER COPY (INITIAL) GOLD

to count.

Authorization to Const. Expired 60 mos from issue