IREDELL COUNTY HEALTH DEPARTMENT

STATESVILLE 704-878-5305 (ar) MOORESVILLE 704-664-5281

IMPROVEMENT PERMIT / AUTHORIZATION TO CONSTRUCT / OPERATION PERMIT / EXISTING SYSTEM INSPECTION

PERMIT # 15e543 PIN # 4772-86-8589 DATE 8-3-09

OWNER or APPLICANT David Upright PHONE: Business Home: 828-44T-4827

OWNER or APPLICANT ADDRESS 154 White Pine Dr Mooresville NC 28115

LOCATION / DIRECTIONS 70 east @ Knox Farm before County line on left

SUBDIVISION BLOCK / SECTION LOT # LOT AREA 5.39 DESIGN FLOW 360 L.T.A.R. 125

Septic Tank 1000 Gallons: STB 1000 Date 6-15-09

Pump Tank 1000 Gallons: P T 374 Date 5-209

Pump Make Goulds Model RES1M 1½ Serial # C095439

Nitrification Field No Fields ___ No Lines 3 Linear Feet 360

Trench Width 36" Max. Trench Bottom Depth 36" Gravel Depth ___

☑ New System ☐ Repair ☐ Expansion System Type I II III IV V VI

System Description: 25% pump PM

Repair System Description: 25% Pump

Maintenance Agreement Required ☐ YES ☑ NO

☐ GRAVITY ☑ PRESSURE

☑ Residence No. Bedrooms 3

☐ Business No. Persons ___

☐ Other No. Employees ___

☐ Slab ☑ Crawl Space

☐ Basement w/plumbing ☐ Basement w/o plumbing


Water Supply: ☑ Private NEW ☐ Public ☐ Community

Comments / Conditions


Comments / Conditions

Lower Repair .2
Upper Repair .25

INITIAL SITE SKETCH

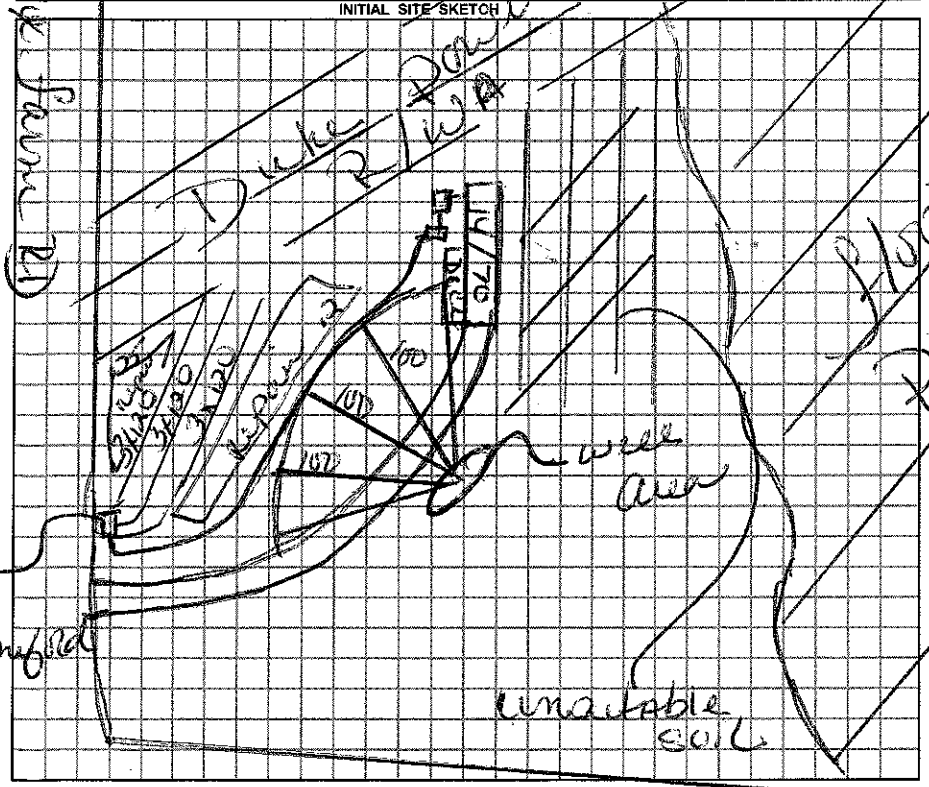

AS BUILT SKETCH

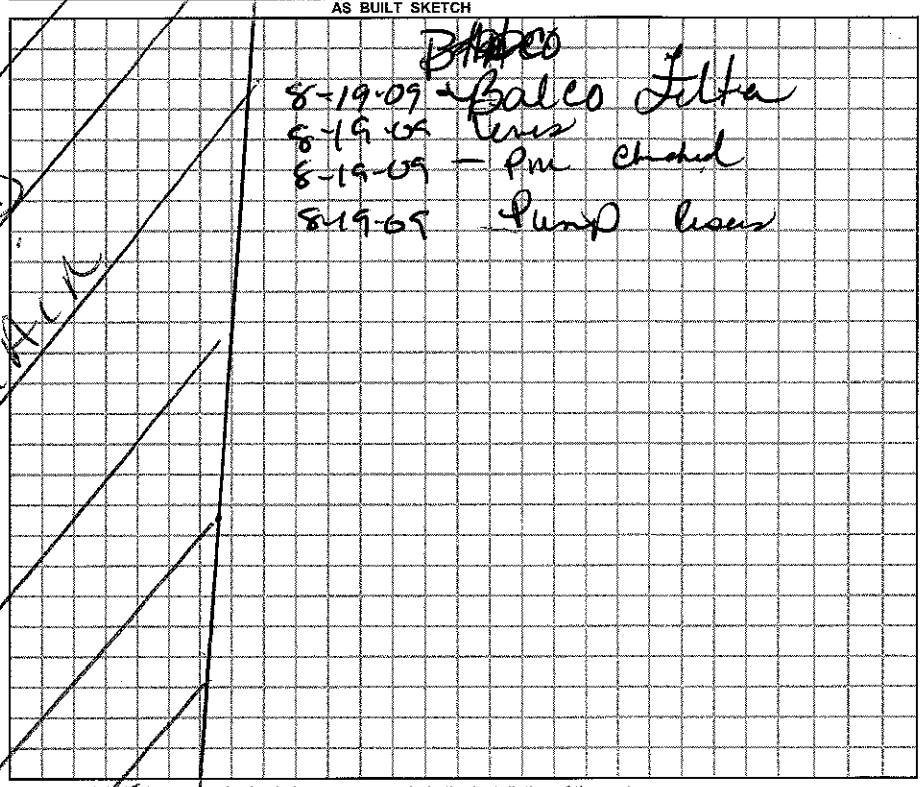

Permit can be suspended or revoked if any false information is supplied toward securing the permit / any unauthorized changes are made to the site / any unauthorized changes are made in the installation of the system.

☐ *IMPROVEMENT PERMIT w / plat valid without expiration.* ☐ *IMPROVEMENT PERMIT w / site plan valid for 60 mos.* ☑ *AUTHORIZATION TO CONSTRUCT valid for period equal to IMPROVEMENT PERMIT-not to exceed 60 mo.*

Owner / Applicant Signature: David L. Upright Date 8/5/09

Improvement Permit by: Date 8-3-09

Authorzation to Construct by: Date 8-3-09

Installed by: Wayne Klontz

Operation Permit by: , R.S. Date: 11 August 10

Existing System Inspected by: Date:

YOU SHOULD CONTACT A LOCATOR SERVICE PRIOR TO ANY EXCAVATION.

WHITE COPY Environmental Health YELLOW COPY (Final) Owner / Applicant PINK COPY (Initial) Owner / Applicant