IREDELL COUNTY HEALTH DEPARTMENT

STATESVILLE 704-878-5305 MOORESVILLE 704-664-5281

IMPROVEMENT PERMIT / AUTHORIZATION TO CONSTRUCT / OPERATION PERMIT / EXISTING SYSTEM INSPECTION

PERMIT# 110152 PIN# 4772-87-7838 DATE 12-13-02

OWNER OR CONTRACTOR FLEETWOOD HOMES of STATESVILLE PHONE: Business 704-872-0179 Home

ADDRESS 1270 NORTHSIDE DRIVE, STATESVILLE, NC 28677

LOCATION US 70 ~~EAST~~, TR KNOX FARM ROAD, 0.7 MILE ON LEFT

SUBDIVISION UPRIGHT ESTATE BLOCK / SECTION 1 LOT 2 LOT AREA 0.75 ACRE SITE CLASS. PS DESIGN FLOW 480 L.T.A.R. 0.20 GPD/FT²

Septic Tank: 1000 Gallons; STB 1012 Date 11/10/02
Pump Tank: ____ Gallons; PT ____ Date ____
Pump Make: ____ Model ____ Serial No. ____
Nitrification Field: No Fields 1 Square Feet ~~600~~ to 2400 Linear Feet 600
No Lines SIX Trench Width 36" Max Trench Bottom Depth 36" Gravel Depth N/A

☑ New System ☐ Repair System Type: I, II, III, IV, V, VI
System Description: 25% REDUCTION, GRAVITY
Repair System Description: 50% REDUCTION, LOW-PRESSURE
Maintenance Agreement Required: ☐ Yes ☑ ~~No~~

☑ ~~House/Mod. Home~~ No. Bedrooms 4
☐ Mobile Home No. Bathrooms 2
☐ Business No. Employees ____
☐ Other ____

☐ Slab ☑ ~~Crawl Space~~ ☐ Basement w/plumbing ☐ Basement wo/plumbing


Water Supply: ☑ ~~Individual~~ ☐ Public ☐ Community
WELL

Comments:/Conditions ① INSTALL 25% REDUCTION SYSTEM ② INSTALL SUB-SURFACE INTERCEPT DRAINAGE DITCH ③ ABANDON EXISTING WELL ACCORDING TO TITLE 15A NCAC, CHAPTER 2C, SECTION .0113.


Comments:/Conditions:
- SEPTIC TANK INSTALLED USING TUFF-TIGHT FILTER + MARKER.

SCALE: 1"=40'

INITIAL SITE SKETCH

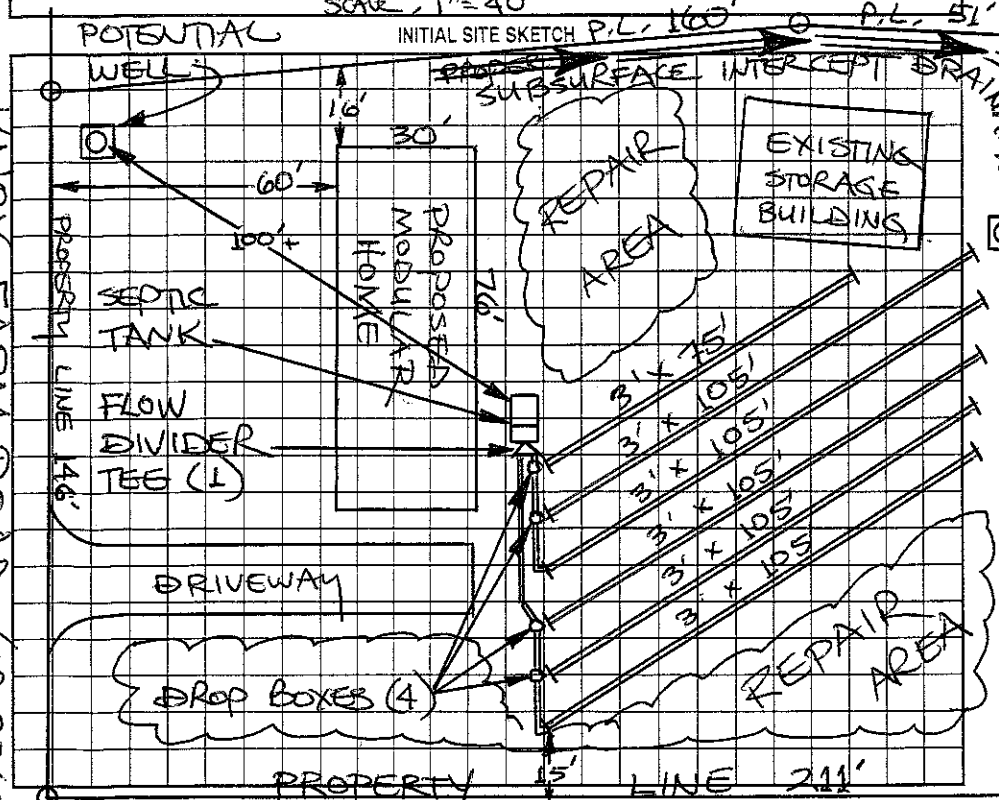

AS BUILT SKETCH

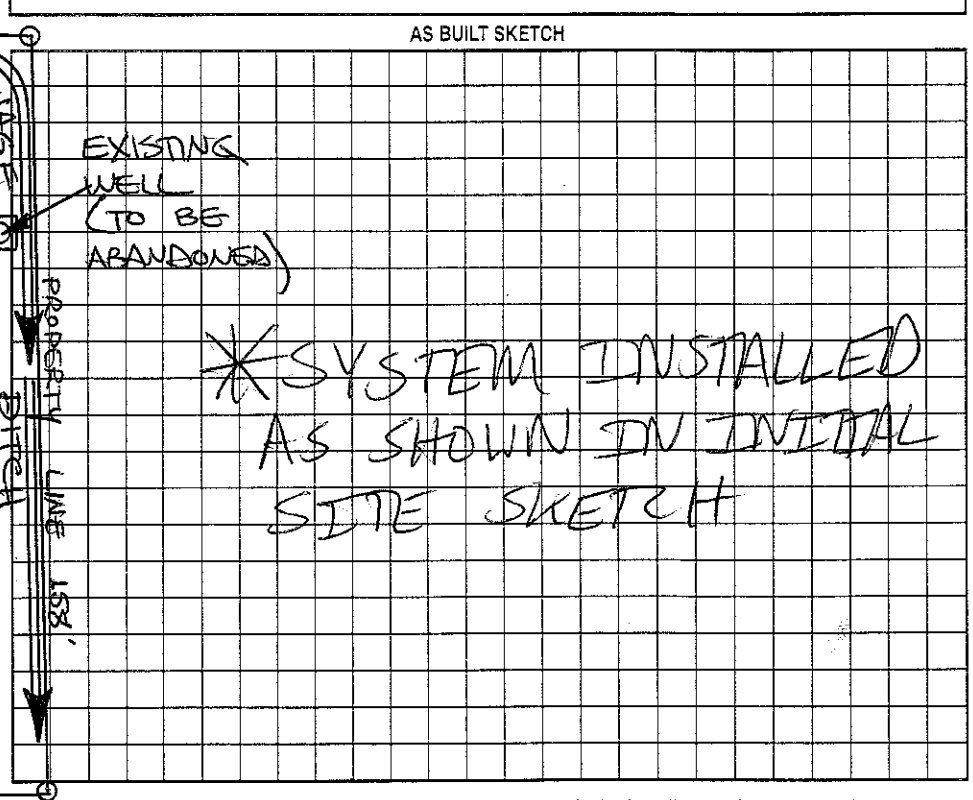

Permit can be suspended or revoked if any false information is supplied toward securing the permit/any unauthorized changes are made to the site/any unauthorized changes are made in the installation of the system. Improvement Permit with plat valid without expiration. Improvement Permit with site plan valid for sixty months. Authorization to Construct is valid for a period equal to that of Improvement Permit – not to exceed sixty months.

Signed: ____ date 12/16/02 Installed by: CRAIG THOMPSON GRADING

Improvement Permit by: STEVE HEDRICK date 12-13-02 Operation Permit by: Patrick Mitchell date 01/13/03

Authorization to Construct by: STEVE HEDRICK date 12-13-02 Existing System Inspection by: ____ date ____

HEALTH DEPT. COPY: WHITE OWNER COPY (FINAL): YELLOW OWNER COPY (INITIAL): PINK