IREDELL COUNTY HEALTH DEPARTMENT

STATESVILLE 704-878-5305 MOORESVILLE 704-664-5281

IMPROVEMENT PERMIT / AUTHORIZATION TO CONSTRUCT / OPERATION PERMIT / EXISTING SYSTEM INSPECTION

PERMIT# 083463 PIN# 4773882657 (RT) DATE April 28, 00

OWNER OR CONTRACTOR Acorn Development PHONE: Business 924-4916 Home

ADDRESS P.O. Box 567 Statesville

LOCATION To East TR Knox Farm Rd. TR Clove Lane on left near end

SUBDIVISION Creekfield BLOCK / SECTION 3 LOT 27 LOT AREA .51 AC SITE CLASS PS DESIGN FLOW 360 gpd L.T.A.R. .3

Septic Tank: 1000 Gallons: STB 1012 Date 2-20-02

Pump Tank: Gallons: PT Date

Pump Make: Model Serial No.

Nitrification Field: No. Fields Square Feet 900 Linear Feet 300

No. Lines 4 @ 75'± Trench Width 36" Max Trench Bottom Depth 36" Gravel Depth N/A

☑ New System ☐ Repair System Type: I II III IV V VI

System Description: Gravity Infiltrative 25% Red

Repair System Description: Gravity / Panel Stack

Maintenance Agreement Required: ☐ Yes ☑ No

☑ House/Mod Home No. Bedrooms 3

☐ Mobile Home No. Bathrooms 2

☐ Business No. Employees

☐ Other


☐ Slab ☑ Crawl Space ☐ Basement w/plumbing ☐ Basement wo/plumbing

Water Supply: ☐ Individual ☐ Public ☐ Community

Comments/Conditions: ONE INSPECTION port PER LATERAL; set flush with finished grade. SIGNED OFF ON 76'x28 HOUSE. KEEP IT 60' OFF ECUNT LINE. SIGNED OFF ON 3 BEDROOM HOME:

Comments/Conditions: IF 4 BEDROOM IT WILL BE DENIED Installed 48 Infiltrative Chambers - polyleft Filter Installed - S. T. marks Installed } B.J.

INITIAL SITE SKETCH 1" = 50'

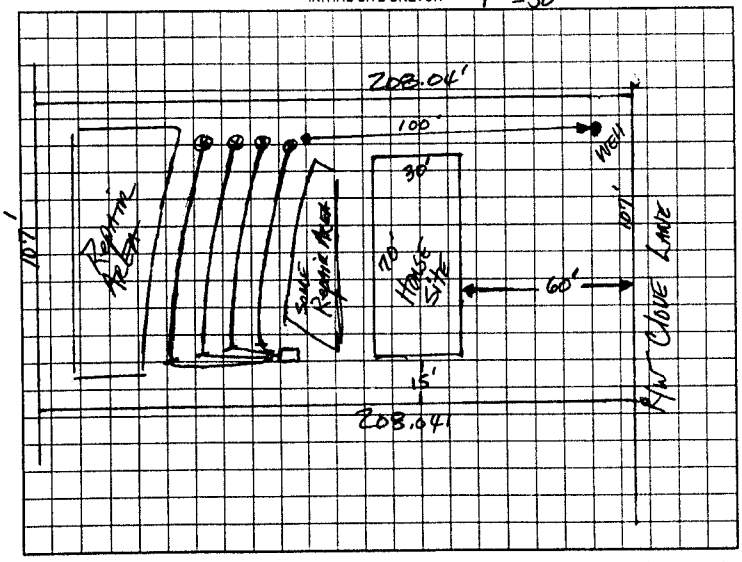

AS BUILT SKETCH

NEEDS TO ELIMINATE 4½ BEDROOM. LC
BEDROOM ELIMINATED & APPROVED BY ENGINEER'S LETTER IS ATTACHED. LC 8-23-02

Installed as Shown per Initial Site Sketch

Permit can be suspended or revoked if any false information is supplied toward securing the permit/any unauthorized changes are made to the site/any unauthorized changes are made in the installation of the system. Improvement Permit with plat valid without expiration. Improvement Permit with site plan valid for sixty months. Authorization to Construct is valid for a period equal to that of Improvement Permit – not to exceed sixty months.

Signed: Mark White date 5/15/00 Installed by: A-1 Backhoe

Improvement Permit by: RS date 4-28-00 Operation Permit by: RS date 08-23-02

Authorization to Construct by: RS date 06-10-02 Existing System Inspection by: date

HEALTH DEPT. COPY: WHITE OWNER COPY (FINAL) YELLOW OWNER COPY (INITIAL) PINK