IREDELL COUNTY HEALTH DEPARTMENT

STATESVILLE 704-878-5305 MOORESVILLE 704-664-5281

IMPROVEMENT PERMIT / AUTHORIZATION TO CONSTRUCT / OPERATION PERMIT / EXISTING SYSTEM INSPECTION

PERMIT# 83267 PIN# 4773882657 DATE 8-10-99

OWNER OR CONTRACTOR Acorn Development PHONE: Business 924 4916 Home

ADDRESS PO Box 5671 Statesville, N.C.

LOCATION 70 E TR Knox Farm TR Sage TO Thyme 5th lot Left.

SUBDIVISION Crestfield BLOCK / SECTION LOT 20 LOT AREA .58 acres SITE CLASS PS DESIGN FLOW 360 L.T.A.R. .13

Septic Tank: 1000 Gallons; STB 1012 Date 2-7-00
Pump Tank: Gallons; PT Date
Pump Make: Model Serial No.
Nitrification Field: No. Fields 1 Square Feet 900 Linear Feet 300
No. Lines 4 Trench Width 36" Max Trench Bottom Depth 36" Gravel Depth N/A

☑ New System ☐ Repair System Type: I II III IV V VI
System Description: Gravi. 2590 Reduction
Repair System Description: " "
Maintenance Agreement Required: ☐ Yes ☑ No


☐ House/Mod. Home No. Bedrooms 3
☑ Mobile Home No. Bathrooms 2
☐ Business No. Employees
☐ Other
☐ Slab ☑ Crawl Space ☐ Basement w/plumbing ☐ Basement wo/plumbing

Water Supply: ☑ Individual ☐ Public ☐ Community


Comments/Conditions:

Comments/Conditions:

INITIAL SITE SKETCH

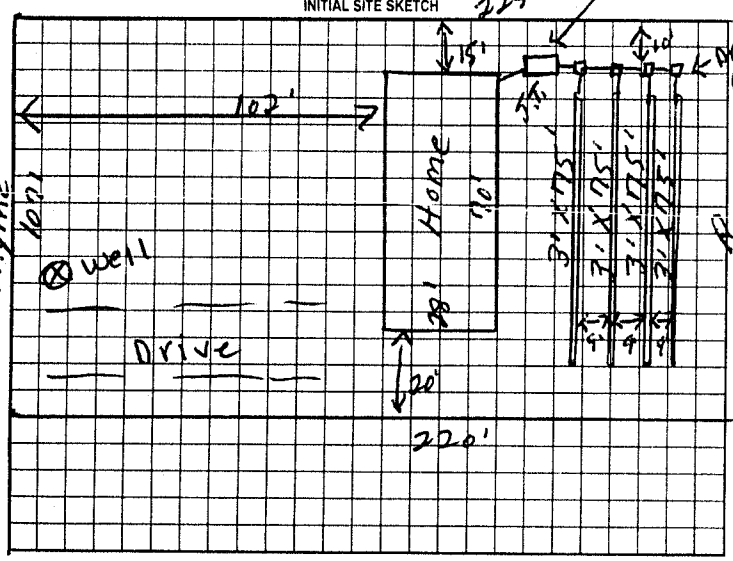

AS BUILT SKETCH

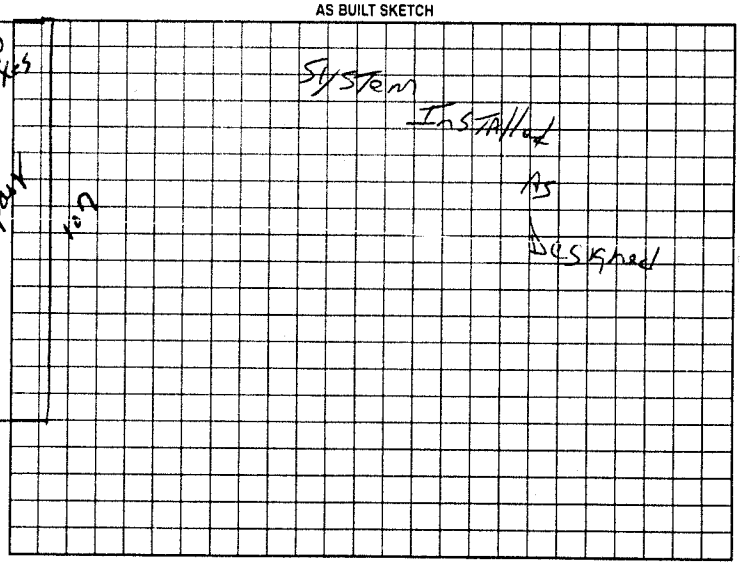

Permit can be suspended or revoked if any false information is supplied toward securing the permit/any unauthorized changes are made to the site/any unauthorized changes are made in the installation of the system. Improvement Permit with plat valid without expiration. Improvement Permit with site plan valid for sixty months. Authorization to Construct is valid for a period equal to that of Improvement Permit – not to exceed sixty months.

Signed: Michael White date 8/12/99 Installed by: Craig Thompson

Improvement Permit by: P.C. Moore date 8-10-99 Operation Permit by: J.C. Potter date 6.5.2000

Authorization to Construct by: P.C. Moore date 8-10-99 Existing System Inspection by: date

HEALTH DEPT COPY: WHITE OWNER COPY (FINAL) YELLOW OWNER COPY (INITIAL) PINK