IREDELL COUNTY HEALTH DEPARTMENT

STATESVILLE 704-878-5305 MOORESVILLE 704-664-5281

IMPROVEMENT PERMIT / AUTHORIZATION TO CONSTRUCT / OPERATION PERMIT / EXISTING SYSTEM INSPECTION

PERMIT# 83461 PIN# 4773882657 (pt) DATE 1/25/01

OWNER OR CONTRACTOR ACORN DEVELOPMENT PHONE: Business 924-4916 Home

ADDRESS P.O. BOX 5671 · STATESVILLE

LOCATION 70 EAST - TR KNOX FARMRD - TR CLOVE LN - OV LT

SUBDIVISION CRESTFIELD BLOCK / SECTION LOT 24,25 LOT AREA ~1AC SITE CLASS PS DESIGN FLOW 360GPD L.T.A.R. 3 gal/sq ft

Septic Tank: 1000 Gallons: STB 825 Date 5-23-01
Pump Tank: Gallons: PT Date
Pump Make: Model Serial No.
Nitrification Field: No Fields 1 Square Feet 900 Linear Feet 300
No Lines 4 @ 75' Trench Width 36" Max Trench Bottom Depth 36" Gravel Depth N/A

☑ New System ☐ Repair System Type: I, II, III, IV, V, VI
System Description: GRAVITY 25% REDUCTION
Repair System Description: LP PANEL
Maintenance Agreement Required: ☐ Yes ☑ No


☑ House/Mod. Home ☐ Mobile Home ☐ Business ☐ Other
No. Bedrooms 3 No. Bathrooms 2 No. Employees

Water Supply: ☑ Individual ☐ Public ☐ Community

☐ Slab ☑ Crawl Space ☐ Basement w/plumbing ☐ Basement wo/plumbing

Comments/Conditions:


INITIAL SITE SKETCH

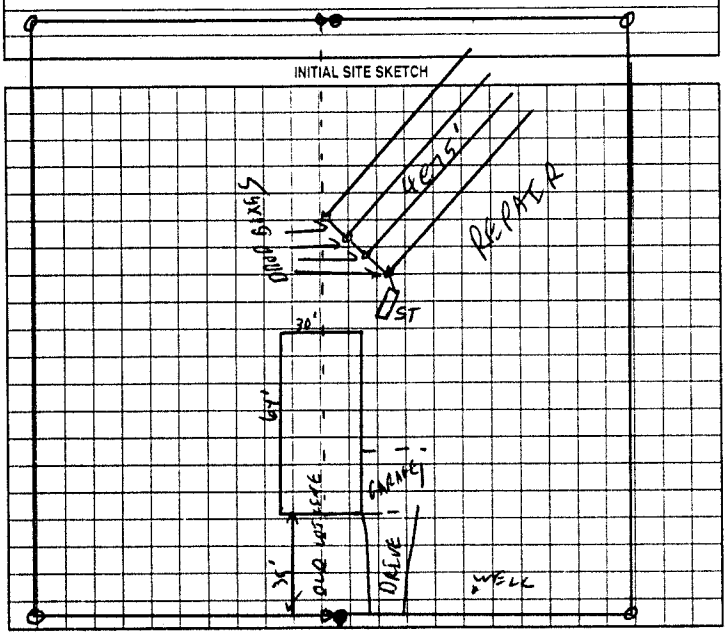

Comments/Conditions -poly lok filter = 300ft HDES Section Installed
- septic tank markers

AS BUILT SKETCH

Not to scale

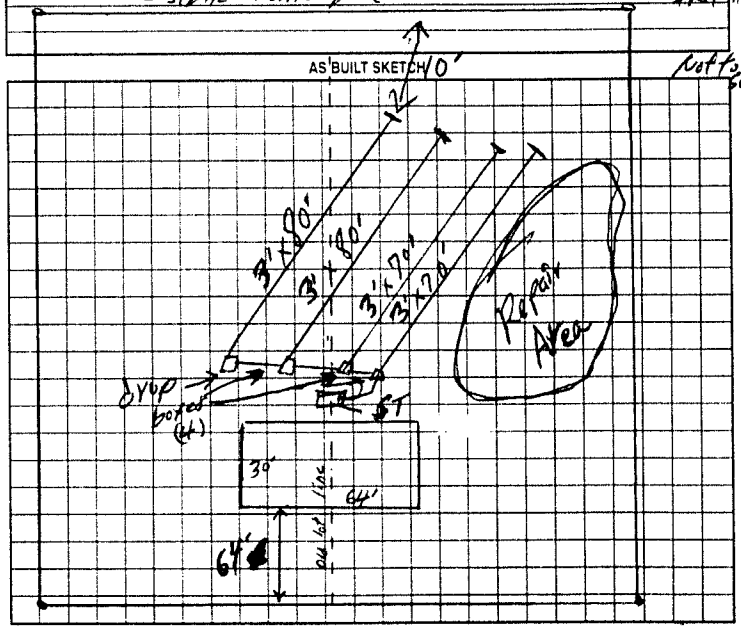

Permit can be suspended or revoked if any false information is supplied toward securing the permit/any unauthorized changes are made to the site/any unauthorized changes are made in the installation of the system. Improvement Permit with plat valid without expiration. Improvement Permit with site plan valid for sixty months. Authorization to Construct is valid for a period equal to that of Improvement Permit – not to exceed sixty months.

Signed: Michael White date

Improvement Permit by: C. [illegible] RS date 1/25/01

Authorization to Construct by: C. [illegible] RS date 1/25/01

Installed by: Bob's Back hoe

Operation Permit by: William O. Johnson date 9/21/01

Existing System Inspection by: date

HEALTH DEPT COPY WHITE OWNER COPY (FINAL) YELLOW OWNER COPY (INITIAL) PINK