IREDELL COUNTY HEALTH DEPARTMENT

STATESVILLE 704-878-5305 MOORESVILLE 704-664-5281

IMPROVEMENT PERMIT / CERTIFICATE OF COMPLETION / OPERATION PERMIT / EXISTING SYSTEM INSPECTION

PROPERTY DESCRIPTION NO. 68017 DATE 7-12-97 TAX MAP NO. 4772 88 2657 Watershed: ☐ Yes ☐ No

OWNER OR CONTRACTOR Acorn Development PHONE: Business 872 0072 Home

ADDRESS PO Box 5671 Sta

LOCATION 70E TR Knox Em Rd 1/4 mi Rt.

SUBDIVISION Crestfield BLOCK / SECTION LOT 2 LOT AREA 21840 SITE CLASS. PS DESIGN FLOW 360 L.T.A.R. .3

Septic Tank: 1000 Gallons; STB 1012 Date 12-23-97

Pump Tank: Gallons; PT Date

Pump Make: Model Serial No.

Nitrification Field: No Fields 1 Square Feet 936 Linear Feet 312

No Lines 4 Trench Width 36" Max Trench Bottom Depth 36" Gravel Depth N/A

☑ New System ☐ Repair System Type: I, II, III, IV, V, VI

System Description: Gravity Chambers

Repair System Description:

Maintenance Agreement Required: ☐ Yes ☑ No

☐ House/Mod. Home No. Bedrooms 3

☑ Mobile Home No. Bathrooms 2

☐ Business No. Employees

☐ Other


☐ Slab ☐ Crawl Space ☐ Basement w/plumbing ☐ Basement wo/plumbing

Water Supply: ☑ Individual ☐ Community ☐ Public


Comments:

Comments:

INITIAL SITE SKETCH

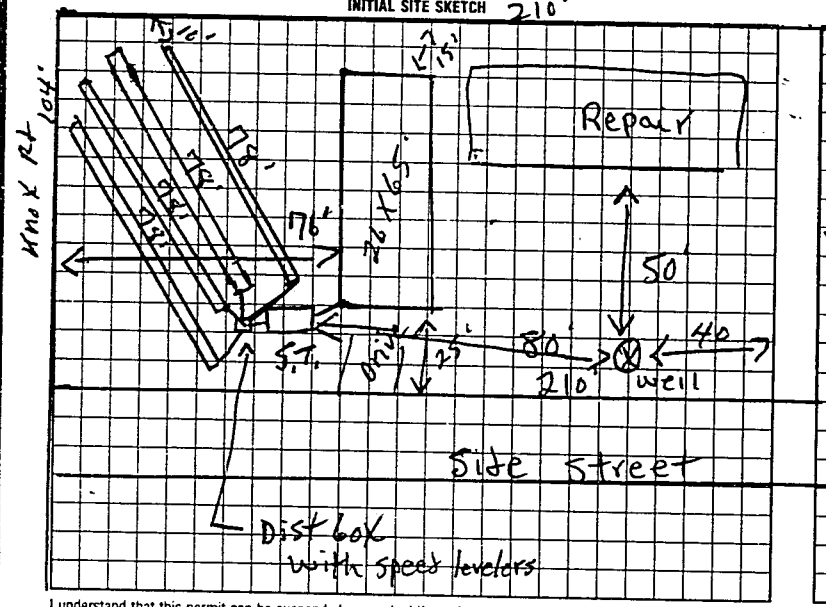

AS BUILT SKETCH

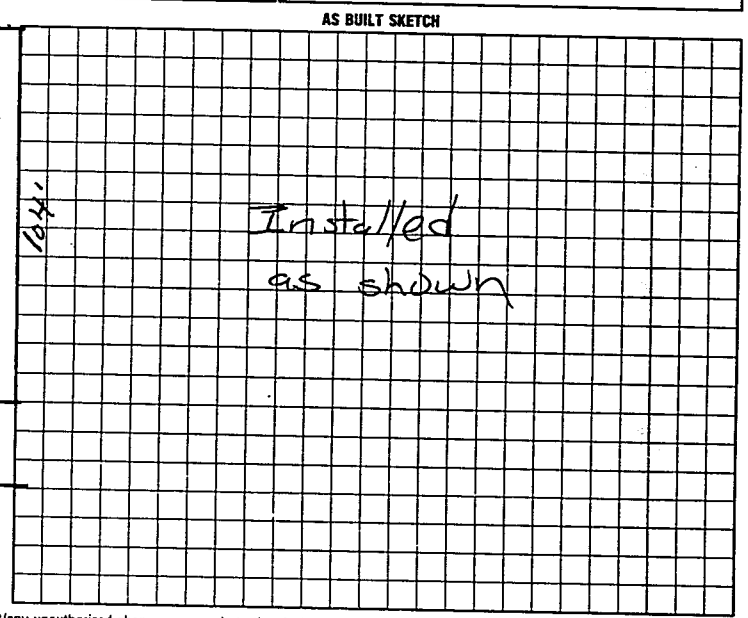

I understand that this permit can be suspended or revoked if any false information is supplied toward securing the permit/any unauthorized changes are made to the site/any unauthorized changes are made in the installation of the system. Improvement Permit is valid for 60 months from date of issuance.

Signed: Thomas & Wrenn

Improvement Permit by: E. C. Moore date 7-12-97

Authorization to Cover Existing System Inspection by: E. C. Moore date 7-12-97

to cover.

Installed by: A-1 Backhoe

Certificate of Completion by: date

Operation Permit by: M. C. Ott RS date 5-22-98

HEALTH DEPT. COPY WHITE INSPECTION COPY (FINAL) GREEN OWNER COPY (FINAL) YELLOW INSPECTION COPY (INITIAL) PINK OWNER COPY (INITIAL) GOLD

Authorization to cover EXPIRES 60 mos from issue