# IREDELL COUNTY HEALTH DEPARTMENT

STATESVILLE 704-878-5305 MOORESVILLE 704-664-5281

## IMPROVEMENT PERMIT / CERTIFICATE OF COMPLETION / OPERATION PERMIT / EXISTING SYSTEM INSPECTION

PROPERTY DESCRIPTION NO. 68018 DATE 7-12-97 TAX MAP NO. 4772 88 2657 Watershed: ☐ Yes ☐ No

OWNER OR CONTRACTOR Acorn Development PHONE: Business 872 0072 Home

ADDRESS PO Box 5671 Sta

LOCATION 70E TR Knox Em Rd 1/4 mi Rt

SUBDIVISION Crestfield BLOCK / SECTION LOT 3 LOT AREA 21528 SF SITE CLASS. PS DESIGN FLOW 360 L.T.A.R. .3

Septic Tank: 1000 Gallons; STB Date

Pump Tank: Gallons; PT Date

Pump Make: Model Serial No.

Nitrification Field: No Fields 1 Square Feet 900 Linear Feet 300

No Lines 4 Trench Width 36" Max Trench Bottom Depth 36" Gravel Depth N/A

☐ New System ☐ Repair System Type: I, II, ☑ IV, V, VI

System Description: Gravity Chamber Panels

Repair System Description:

Maintenance Agreement Required: ☐ Yes ☑ No

☐ House/Mod. Home ☑ Mobile Home ☐ Business ☐ Other

No. Bedrooms 3 No. Bathrooms 2 No. Employees

☐ Slab ☑ Crawl Space ☐ Basement w/plumbing ☐ Basement wo/plumbing

Water Supply: ☑ Individual ☐ Community ☐ Public


Comments:

MH is 106' from R/W on Knox Em Rd


Comments:

Note able to add the 18ft in the other lines - used dist Box

INITIAL SITE SKETCH

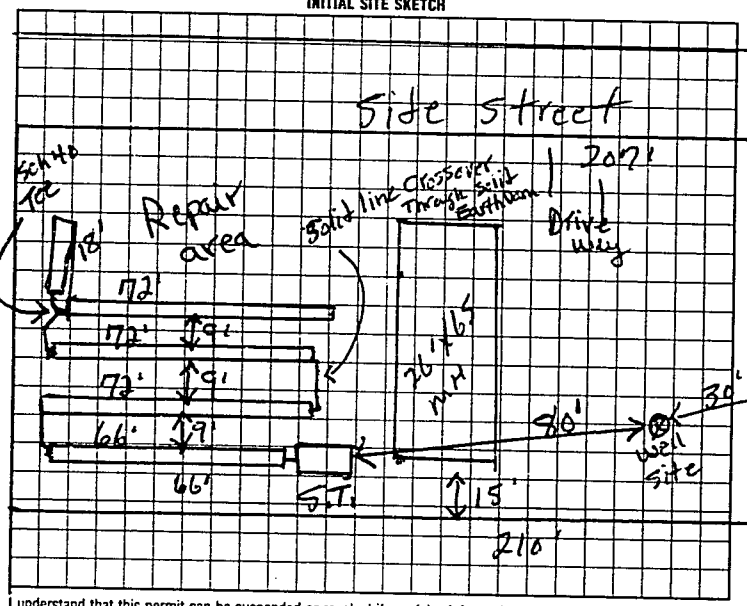


AS BUILT SKETCH

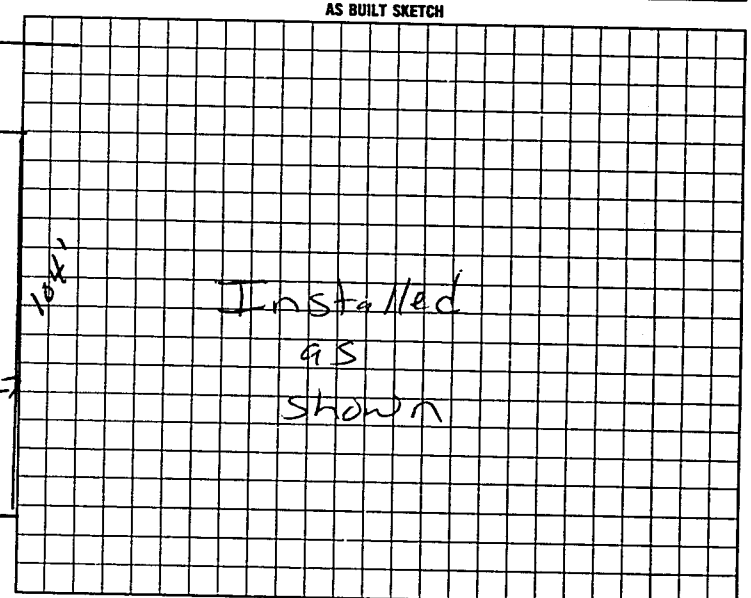


I understand that this permit can be suspended or revoked if any false information is supplied toward securing the permit/any unauthorized changes are made to the site/any unauthorized changes are made in the installation of the system. Improvement Permit is valid for 60 months from date of issuance.

Signed: Thomas J. White

Improvement Permit by: L.C. Moore date 7-12-97

~~Authorization~~ Existing System Inspection by: L.C. Moore date 7-12-97

to cont.

Installed by: A-1

Certificate of Completion by: date

Operation Permit by: Mark C. Ott RS date 4-1-98

Authorization to cont EXPIRES 60 mos from issue

HEALTH DEPT COPY (WHITE) INSPECTION COPY (FINAL) GREEN OWNER COPY (FINAL) YELLOW INSPECTION COPY (INITIAL) PINK OWNER COPY (INITIAL) GOLD