#73593 Michael Dickson

IREDELL COUNTY HEALTH DEPARTMENT

STATESVILLE 704-878-5305 MOORESVILLE 704-664-5281

IMPROVEMENT PERMIT / CERTIFICATE OF COMPLETION / OPERATION PERMIT / EXISTING SYSTEM INSPECTION

PROPERTY DESCRIPTION NO. 67387 DATE 7-12-97 TAX MAP NO. 4772 88 2657 Watershed: ☐ Yes ☐ No

OWNER OR CONTRACTOR Acorn Development PHONE: Business 872-0072 Home

ADDRESS PO Box 5671 Sta

LOCATION 70E TR Knox Emrd 1/4 mi Rt.

SUBDIVISION Crestfield BLOCK / SECTION LOT 5 LOT AREA 31200 Sq' SITE CLASS PS DESIGN FLOW 360 L.T.A.R. .3

Septic Tank: 1000 Gallons; STB 1012 Date 3-20-98
Pump Tank: 1000 Gallons; PT 17 Date 9-29-97
Pump Make: Hydromatic Model 51644007 Serial No. 5K52A1
Nitrification Field: No Fields 1 Square Feet 936 Linear Feet 312
No Lines 4 Trench Width 36" Max Trench Bottom Depth 36" Gravel Depth N/A

☑ New System ☐ Repair System Type: I, II, III, IV, V, VI
System Description: Pump To Chambers
Repair System Description: " " "
Maintenance Agreement Required: ☐ Yes ☑ No

☐ House/Mod. Home No. Bedrooms 3
☑ Mobile Home No. Bathrooms 2
☐ Business No. Employees
☐ Other


☐ Slab ☑ Crawl Space ☐ Basement w/plumbing ☐ Basement w/o plumbing

Water Supply: ☑ Individual ☐ Community ☐ Public


Comments:
See Attached sheets for Pump Tank Pressure manifold & clean out set up which are part of this permit.

Comments: Septic Tank and
*Note: Pump tank moved to opposite side of house - Manifold to opposite side

INITIAL SITE SKETCH

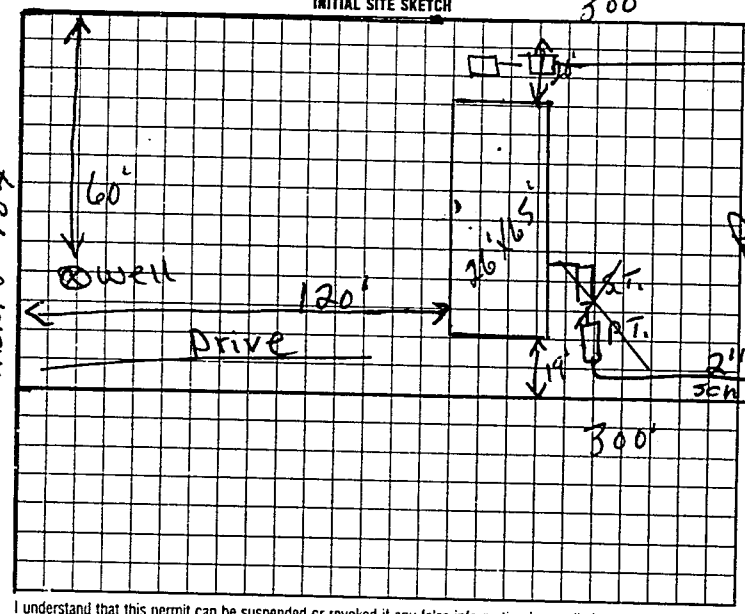

AS BUILT SKETCH

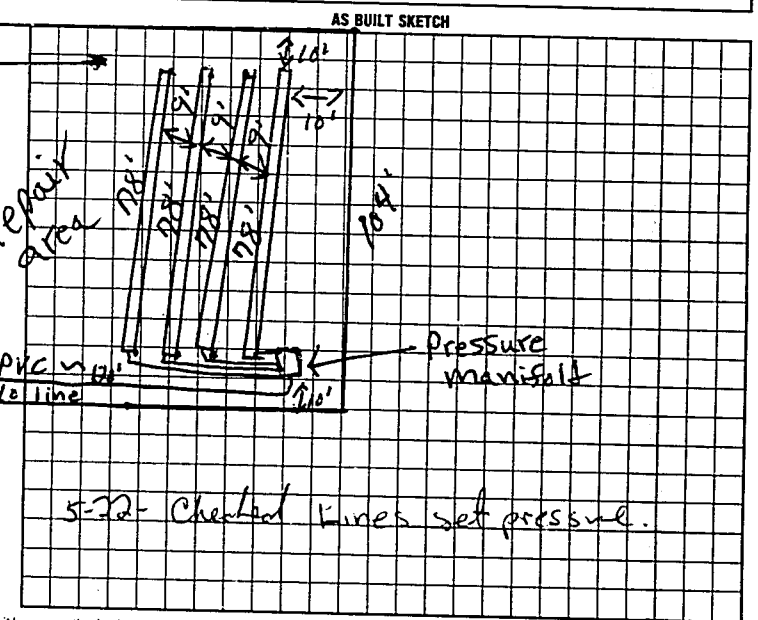

I understand that this permit can be suspended or revoked if any false information is supplied toward securing the permit/any unauthorized changes are made to the site/any unauthorized changes are made in the installation of the system. Improvement Permit is valid for 60 months from date of issuance.

Signed: Thomas J White

Improvement Permit by: P.C. Moore date 7-13-97

Authorization to Construct by: P.C. Moore date 7-13-97

Installed by: A-1 Backhoe

Certificate of Completion by: P.C. Moore date

Operation Permit by: P.C. Moore date 7-2-98

HEALTH DEPT. COPY: WHITE INSPECTION COPY (FINAL): GREEN OWNER COPY (FINAL): YELLOW INSPECTION COPY (INITIAL): PINK OWNER COPY (INITIAL): GOLD

Authorization to Construct EXPires 60 mos from issue