IREDELL COUNTY HEALTH DEPARTMENT

STATESVILLE 704-878-5305 MOORESVILLE 704-664-5281

IMPROVEMENT PERMIT / CERTIFICATE OF COMPLETION / OPERATION PERMIT / EXISTING SYSTEM INSPECTION

PROPERTY DESCRIPTION NO. 67388 DATE 7-12-97 TAX MAP NO. 4702 88 2652 Watershed: ☐ Yes ☐ No

OWNER OR CONTRACTOR Acorn Development PHONE: Business 872-0072 Home

ADDRESS PO BX 5671 Sta NC.

LOCATION 70E TR Knox Fm Rd 1/4 mi Rt.

SUBDIVISION Crestfield BLOCK / SECTION LOT 6 LOT AREA 31,200 SITE CLASS. PS DESIGN FLOW 360 L.T.A.R. .3

Septic Tank: 1000 Gallons; STB 1012 Date 2-23-98
Pump Tank: Gallons; PT Date
Pump Make: Model Serial No.
Nitrification Field: No Fields 1 Square Feet 918 Linear Feet 306
No Lines 3 Trench Width 36" Max Trench Bottom Depth 36" Gravel Depth N/A

☑ New System ☐ Repair System Type: I, II, III, IV, V, VI
System Description: Gravity Chambers
Repair System Description: Pump To Panels
Maintenance Agreement Required: ☐ Yes ☑ No

☐ House/Mod. Home No. Bedrooms 3
☑ Mobile Home No. Bathrooms 2
☐ Business No. Employees
☐ Other
☐ Slab ☑ Crawl Space ☐ Basement w/plumbing ☐ Basement wo/plumbing

Water Supply: ☑ Individual ☐ Community ☐ Public


Comments:

Comments:


Existing well to be abandon according to State Dept of Environmental Management Standards

Will have to be done prior to operation permit ~~completion~~ being issued

INITIAL SITE SKETCH

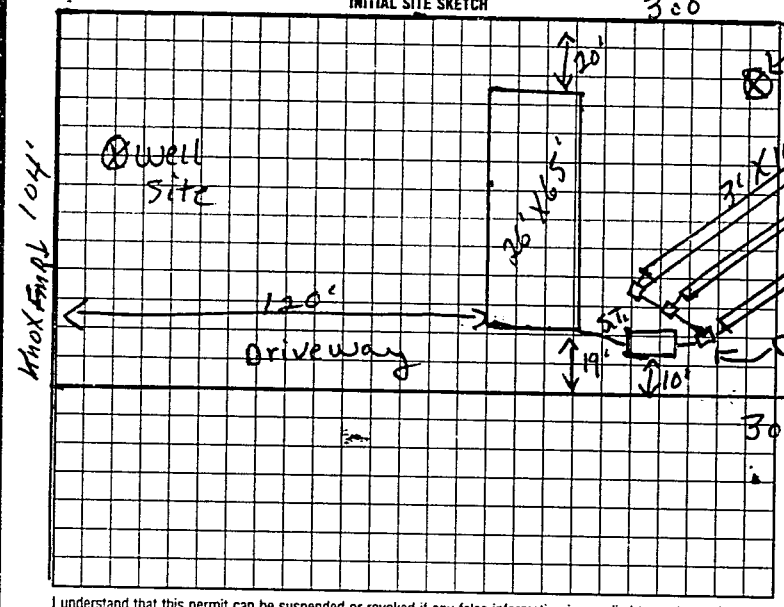

AS BUILT SKETCH

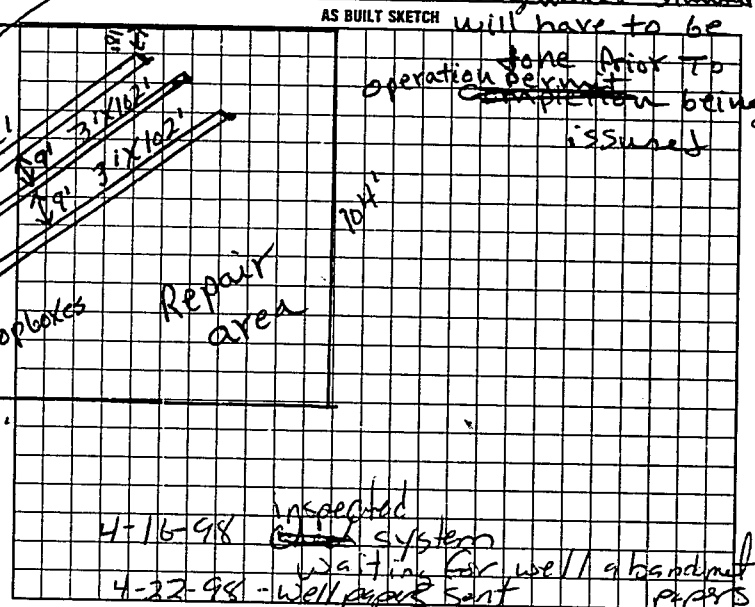

Knox Fm Rd 104'

4-16-98 Inspected ~~final~~ system waiting for well & abandonment papers

4-22-98 - Well papers sent

I understand that this permit can be suspended or revoked if any false information is supplied toward securing the permit/any unauthorized changes are made to the site/any unauthorized changes are made in the installation of the system. Improvement Permit is valid for 60 months from date of issuance.

Signed:

Improvement Permit by: L.C. moore date 7-12-97

Authorization to cont. L.C. moore date 7-12-97

Installed by: A-1

Certificate of Completion by: date

Operation Permit by RS date 4-23-98

HEALTH DEPT COPY WHITE — INSPECTION COPY (FINAL) GREEN — OWNER COPY (FINAL) YELLOW — INSPECTION COPY (INITIAL) PINK — OWNER COPY (INITIAL) GOLD

Authorization to cont Expires 60 mos from issue

S88200