IREDELL COUNTY HEALTH DEPARTMENT

STATESVILLE 704-878-5305 MOORESVILLE 704-664-5281

IMPROVEMENT PERMIT / CERTIFICATE OF COMPLETION / OPERATION PERMIT / EXISTING SYSTEM INSPECTION

PROPERTY DESCRIPTION NO. 67389 DATE 7-12-97 TAX MAP NO. 4772-88-2657 Watershed: ☐ Yes ☐ No

OWNER OR CONTRACTOR Acorn Development PHONE: Business 872-0072 Home

ADDRESS PO Box 5671 Sta NC.

LOCATION 70 E TR Knox Rd 1/4 mi rt

SUBDIVISION Crest Field BLOCK / SECTION LOT 7 LOT AREA 31200 SQ' SITE CLASS. PS DESIGN FLOW 360 L.T.A.R. .3

Septic Tank: 1000 Gallons; STB 1012 Date 1-14-98

Pump Tank: Gallons; PT Date

Pump Make: Model Serial No.

Nitrification Field: No Fields 1 Square Feet 900 Linear Feet 300

No Lines 3 Trench Width 36" Max Trench Bottom Depth 36" Gravel Depth N/A

☑ New System ☐ Repair System Type: I, II, (III), IV, V, VI

System Description: Gravity Chambers

Repair System Description: LPP Panels

Maintenance Agreement Required: ☐ Yes ☑ No

☐ House/Mod. Home ☑ Mobile Home ☐ Business ☐ Other

No. Bedrooms 3 No. Bathrooms 2 No. Employees


☐ Slab ☑ Crawl Space ☐ Basement w/plumbing ☐ Basement wo/plumbing

Water Supply: ☑ Individual ☐ Community ☐ Public


Comments:

Comments:

INITIAL SITE SKETCH

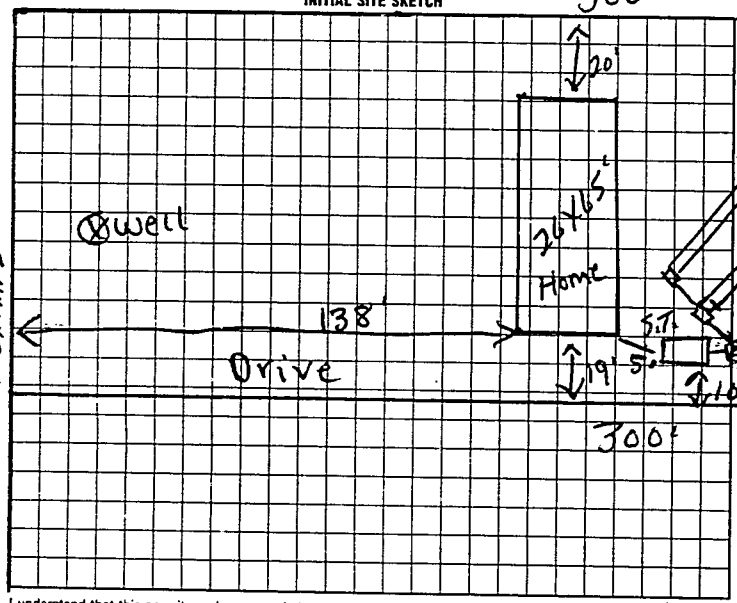

AS BUILT SKETCH

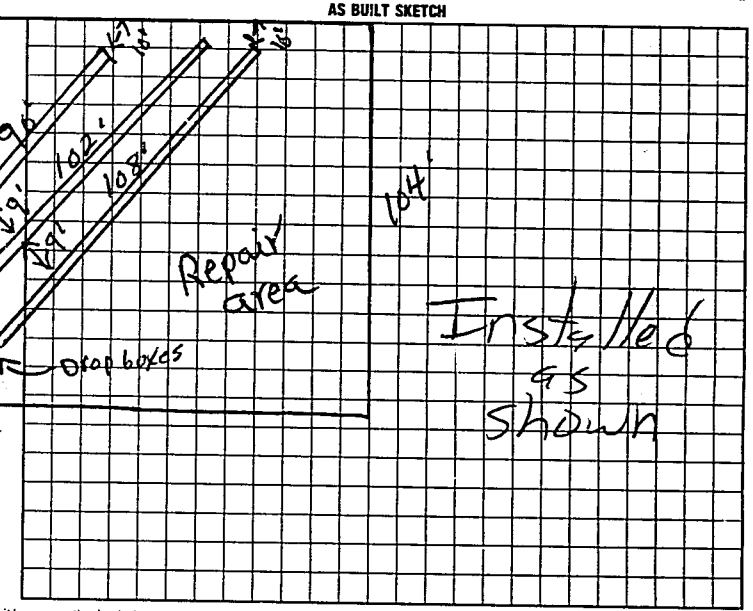

I understand that this permit can be suspended or revoked if any false information is supplied toward securing the permit/any unauthorized changes are made to the site/any unauthorized changes are made in the installation of the system. Improvement Permit is valid for 60 months from date of issuance.

Signed: Thomas J White

Improvement Permit by: E.C. moore date 7-12-97

~~Authorization~~ E.C. moore date 7-12-97

to cover: HEALTH DEPT COPY (WHITE) INSPECTION COPY (FINAL) GREEN OWNER COPY (FINAL) YELLOW

Installed by: A-1 Backhoe

Certificate of Completion by: date

Operation Permit by date 9-1-98

INSPECTION COPY (INITIAL) PINK OWNER COPY (INITIAL) GOLD

Authorization to count Expires 60 mos from issue