IREDELL COUNTY HEALTH DEPARTMENT

STATESVILLE 704-878-5305 MOORESVILLE 704-664-5281

IMPROVEMENT PERMIT / CERTIFICATE OF COMPLETION / OPERATION PERMIT / EXISTING SYSTEM INSPECTION

PROPERTY DESCRIPTION NO. 67390 DATE 7-12-97 TAX MAP NO. 4772-88-2657 Watershed: ☐ Yes ☐ No

OWNER OR CONTRACTOR Acorn Bldg Co. PHONE: Business 872-0072 Home

ADDRESS PO Box 5671 Sta NSC.

LOCATION 70E TR Knox Fm Rd 1/4 mi Rt

SUBDIVISION Crestfield BLOCK / SECTION LOT 8 LOT AREA 3/2005' SITE CLASS. PS DESIGN FLOW 360 L.T.A.R. .13

Septic Tank: 1000 Gallons; STB Date

Pump Tank: Gallons; PT Date

Pump Make: Model Serial No.

Nitrification Field: No Fields 1 Square Feet 900 Linear Feet 300

No Lines 3 Trench Width 36" Max Trench Bottom Depth 36" Gravel Depth N/A

☑ New System ☐ Repair System Type: I, II, III, IV, V, V

System Description: ~~Gravity~~ Gravity Chambers

Repair System Description: Pump To Panels

Maintenance Agreement Required: ☐ Yes ☐ No

☑ House/Mod. Home No. Bedrooms 3

☐ Mobile Home No. Bathrooms 2

☐ Business No. Employees

☐ Other


☐ Slab ☑ Crawl Space ☐ Basement w/plumbing ☐ Basement wo/plumbing

Water Supply: ☑ Individual ☐ Community ☐ Public


Comments:

Comments: Well + Home Not on Site at Time of This inspection

INITIAL SITE SKETCH

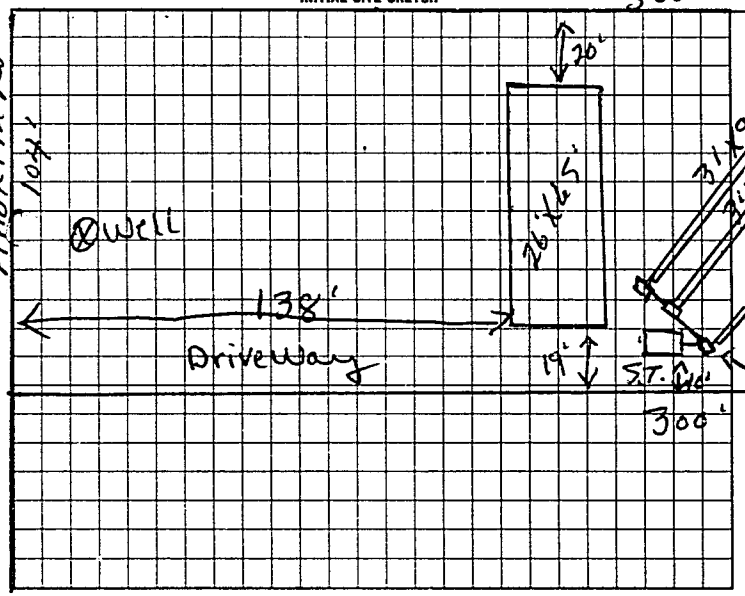

AS BUILT SKETCH

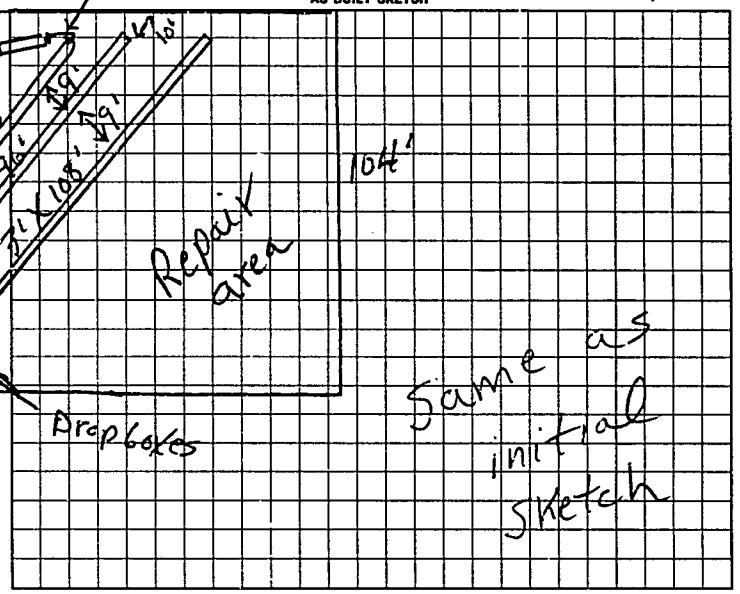

Same as initial sketch

I understand that this permit can be suspended or revoked if any false information is supplied toward securing the permit/any unauthorized changes are made to the site/any unauthorized changes are made in the installation of the system. Improvement Permit is valid for 60 months from date of issuance.

Signed: [signature]

Installed by: A-1 Backhoe

Improvement Permit by: L. C. Moore date 7-12-97

Certificate of Completion by: date

Authorization L. C. Moore date 7-12-97

Operation Permit by: L. C. Moore date 11-17-97

to count.

Authorization to count EXPIRES 60 mos FROM ISSUE

HEALTH DEPT COPY WHITE | INSPECTION COPY (FINAL) GREEN | OWNER COPY (FINAL) YELLOW | INSPECTION COPY (INITIAL) PINK | OWNER COPY (INITIAL) GOLD

6 1 6 2 0 0