IREDELL COUNTY HEALTH DEPARTMENT

STATESVILLE 704-878-5305 MOORESVILLE 704-664-5281

IMPROVEMENT PERMIT / AUTHORIZATION TO CONSTRUCT / OPERATION PERMIT / EXISTING SYSTEM INSPECTION

PERMIT# 74634 PIN# 4773 88 2657 DATE 6-20-98

OWNER OR CONTRACTOR Acorn Development Inc. PHONE: Business 872 0072 Home

ADDRESS 517 Stinson St. Statesville, NC

LOCATION 170 E TR Knox Fm Rd TR Sage Ln 4th lot Rt

SUBDIVISION Crestfield BLOCK / SECTION II LOT 13 LOT AREA 20000 SITE CLASS PS DESIGN FLOW 360 L.T.A.R. .3

Septic Tank: 1000 Gallons; STB 1012 Date 6-1-99
Pump Tank: Gallons; PT Date
Pump Make: Model Serial No.
Nitrification Field: No Fields 1 Square Feet 900 Linear Feet 300
No Lines 3 Trench Width 36" Max Trench Bottom Depth 36" Gravel Depth N/A

[x] New System [ ] Repair System Type: I, II, III, IV, V, VI
System Description: 25% Redu System
Repair System Description: " " "
Maintenance Agreement Required: [ ] Yes [x] No


[ ] House/Mod. Home No. Bedrooms 3
[ ] Mobile Home No. Bathrooms 2
[ ] Business No. Employees
[ ] Other
[ ] Slab [x] Crawl Space [ ] Basement w/plumbing [ ] Basement wo/plumbing

Water Supply: [x] Individual [ ] Public [ ] Community

Comments:/Conditions:

Comments:/Conditions: check S.T. + 1st Two lines 8-11-99 JCM

INITIAL SITE SKETCH

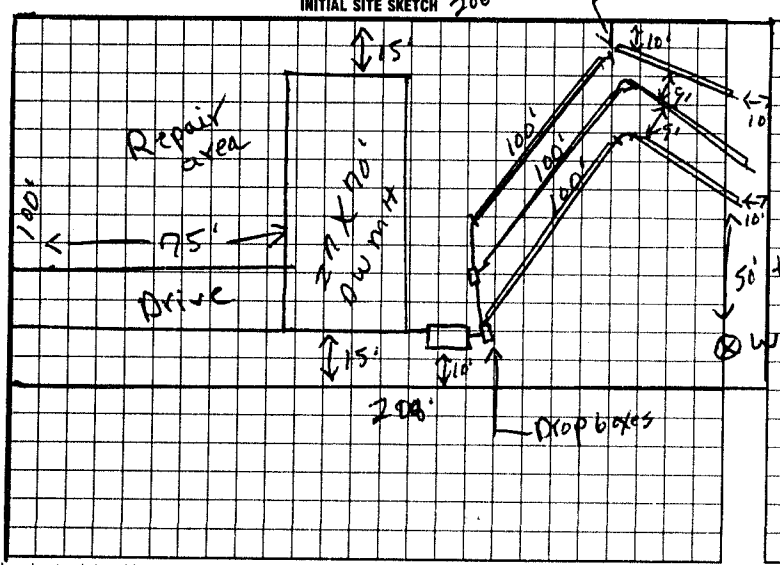

AS BUILT SKETCH

SEPTIC TANK W/ RISERS INSTALLED USING "POLY LOK" FILTER

FORTY-EIGHT "INFILTRATOR" CHAMBERS INSTALLED AS SHOWN ON INITIAL SITE SKETCH

I understand that this permit can be suspended or revoked if any false information is supplied toward securing the permit/any unauthorized changes are made to the site/any unauthorized changes are made in the installation of the system. Improvement Permit with plat valid without expiration. Improvement Permit with site plan valid for sixty months. Authorization to Construct is valid for a period equal to that of Improvement Permit – not to exceed sixty months.

Signed: Thomas J White date 7-21-98 Installed by: CRAIG THOMPSON GRADING

Improvement Permit by: R. C. Moore date 6-20-98 Operation Permit by: STEVE HEDRICK date 8-12-99

Authorization to Construct by: R. C. Moore date 6-20-98 Existing System Inspection by: date

HEALTH DEPT. COPY: WHITE INSPECTION COPY (FINAL) GREEN OWNER COPY (FINAL) YELLOW INSPECTION COPY (INITIAL) PINK OWNER COPY (INITIAL) GOLD