IREDELL COUNTY HEALTH DEPARTMENT

STATESVILLE 704-878-5305 MOORESVILLE 704-664-5281

IMPROVEMENT PERMIT / AUTHORIZATION TO CONSTRUCT / OPERATION PERMIT / EXISTING SYSTEM INSPECTION

PERMIT# 74632 PIN# 4773 88 2657 DATE 6-20-98

OWNER OR CONTRACTOR Acorn Development Inc. PHONE: Business 872-0072 Home

ADDRESS 517 Stinson Ct. Statesville, N.C.

LOCATION 70E TR Knox Rd TR Sage Lane 3rd lot Rt.

SUBDIVISION Crestfield BLOCK / SECTION II LOT 12 LOT AREA 20966 SITE CLASS PS DESIGN FLOW 360 L.T.A.R. .3

Septic Tank: 1000 Gallons: STB 794 Date 1-19-99
Pump Tank: Gallons; PT Date
Pump Make: Model Serial No.
Nitrification Field: No Fields 1 Square Feet 900 Linear Feet 300
No Lines 4 Trench Width 36" Max Trench Bottom Depth 36" Gravel Depth N/A

[X] New System [ ] Repair System Type: I, II, III, IV, V, VI
System Description: 25% Reduction System
Repair System Description:
Maintenance Agreement Required: [ ] Yes [X] No
[ ] Slab [X] Crawl Space [ ] Basement w/plumbing [ ] Basement wo/plumbing


[ ] House/Mod. Home No. Bedrooms 3
[X] Mobile Home No. Bathrooms 2
[ ] Business No. Employees
[ ] Other

Water Supply: [X] Individual [ ] Public [ ] Community


Comments:/Conditions:

Comments:/Conditions: Well not onsite at Time of This inspection

INITIAL SITE SKETCH 208'

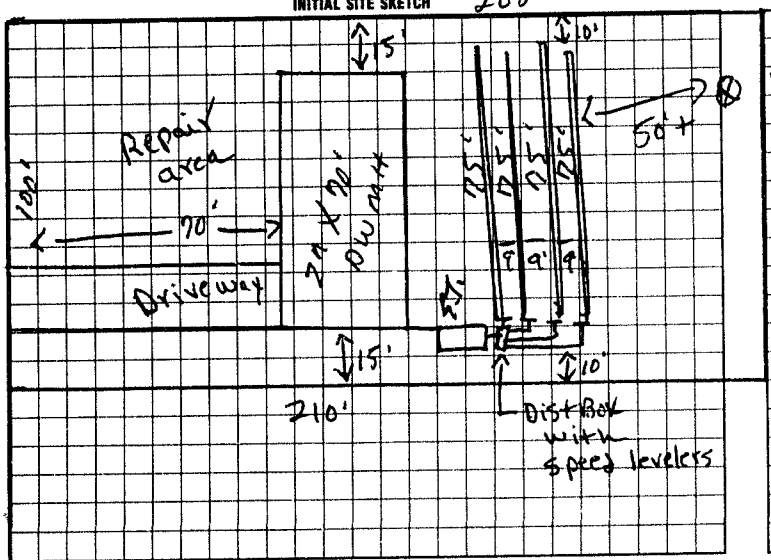

AS BUILT SKETCH

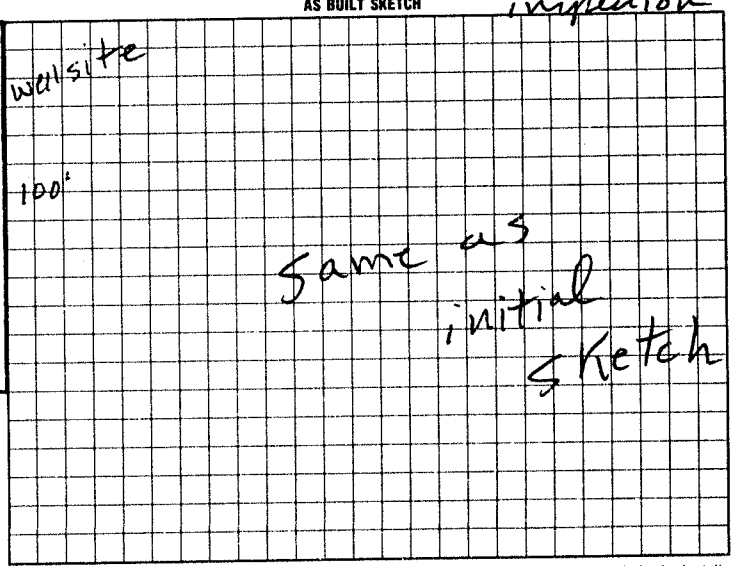

I understand that this permit can be suspended or revoked if any false information is supplied toward securing the permit/any unauthorized changes are made to the site/any unauthorized changes are made in the installation of the system. Improvement Permit with plat valid without expiration. Improvement Permit with site plan valid for sixty months. Authorization to Construct is valid for a period equal to that of Improvement Permit – not to exceed sixty months.

Signed: Thomas J White date 7-21-99 Installed by: Atlantic Excavating

Improvement Permit by: R. C. Moore date 6-20-98 Operation Permit by: R. C. Moore date 5-10-99

Authorization to Construct by: R. C. Moore date 6-20-98 Existing System Inspection by: date

HEALTH DEPT. COPY: WHITE INSPECTION COPY (FINAL) GREEN OWNER COPY (FINAL) YELLOW INSPECTION COPY (INITIAL) PINK OWNER COPY (INITIAL) GOLD