IREDELL COUNTY HEALTH DEPARTMENT

STATESVILLE 704-878-5305 MOORESVILLE 704-664-5281

IMPROVEMENT PERMIT / CERTIFICATE OF COMPLETION / OPERATION PERMIT / EXISTING SYSTEM INSPECTION

PROPERTY DESCRIPTION NO. 67391 DATE 7-3-97 TAX MAP NO. 4777288657 Watershed: ☐ Yes ☒ No

OWNER OR CONTRACTOR Acorn Development PHONE: Business 704 872 0072 Home

ADDRESS

LOCATION 70E Sin TR Knox Rd 1/4mi Rt Stinson Ct Statesville, N.C.

SUBDIVISION Crestfield BLOCK / SECTION LOT 9 LOT AREA 30678 SITE CLASS. PS DESIGN FLOW 360 L.T.A.R. .25

Septic Tank: 1000 Gallons; STB 1013 Date 5-8-97

Pump Tank: Gallons; PT Date

Pump Make: Model Serial No.

Nitrification Field: No Fields 1 Square Feet 1080 Linear Feet 360

No Lines 4 Trench Width 36" Max Trench Bottom Depth 36" Gravel Depth N/A

☒ New System ☐ Repair System Type: I, II, III, IV, V, VI

System Description: Gravity Chambers

Repair System Description: pump to panels

Maintenance Agreement Required: ☐ Yes ☐ No

☒ House/Mod. Home No. Bedrooms 3

☐ Mobile Home No. Bathrooms 2

☐ Business No. Employees

☐ Other


☐ Slab ☒ Crawl Space ☐ Basement w/plumbing ☐ Basement wo/plumbing

Water Supply: ☒ Individual ☐ Community ☐ Public


Comments:

Comments: Well & Home not located at Time of this inspection

INITIAL SITE SKETCH

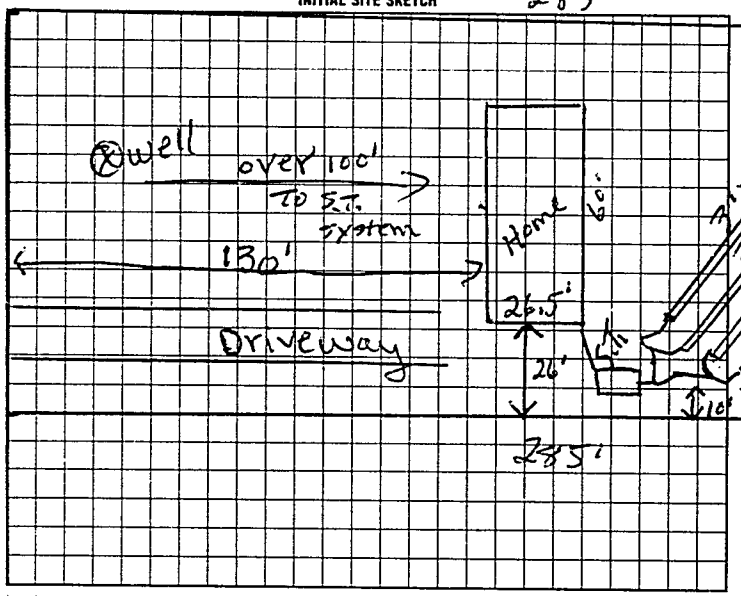

AS BUILT SKETCH

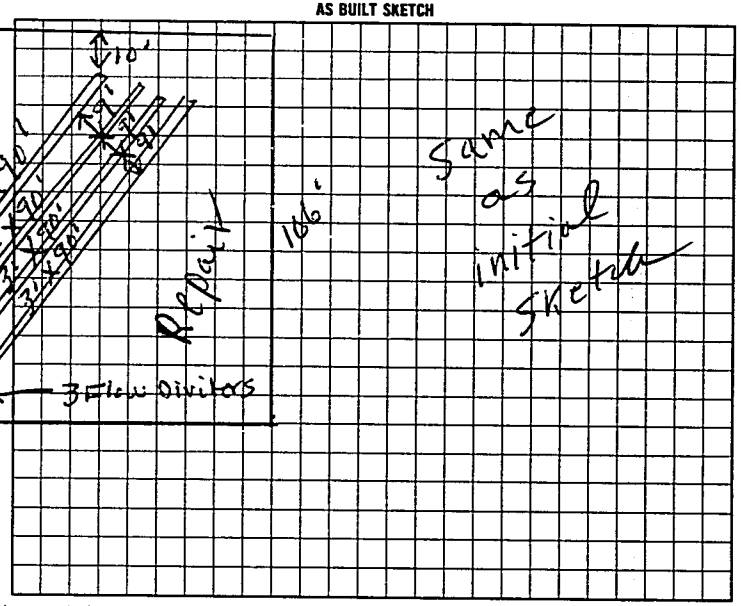

I understand that this permit can be suspended or revoked if any false information is supplied toward securing the permit/any unauthorized changes are made to the site/any unauthorized changes are made in the installation of the system. Improvement Permit is valid for 60 months from date of issuance.

Signed: Thomas J. Acorn

Improvement Permit by: L. C. Moore date 7-3-97

Authorization to Construct by: L. C. Moore date 7-3-97

Existing System Inspection by:

Installed by: A-1 Backhoe

Certificate of Completion by: date

Operation Permit by: L. C. Moore date 10-28-97

HEALTH DEPT COPY WHITE INSPECTION COPY (FINAL) GREEN OWNER COPY (FINAL) YELLOW INSPECTION COPY (INITIAL) PINK OWNER COPY (INITIAL) GOLD

to Const.

Authorization to Const. Expires 60 mos. from issue

1266200