# IREDELL COUNTY HEALTH DEPARTMENT

STATESVILLE 704-878-5305 MOORESVILLE 704-664-5281

## IMPROVEMENT PERMIT / CERTIFICATE OF COMPLETION / OPERATION PERMIT / EXISTING SYSTEM INSPECTION

PROPERTY DESCRIPTION NO. 67392 DATE 7-3-97 TAX MAP NO 4772 88 2651 Watershed: ☐ Yes ☑ No

OWNER OR CONTRACTOR Acorn Development PHONE: Business 7048720002 Home

ADDRESS

LOCATION 706 517 Tr 5 Stinson Ct. 1/4 mi Rt Knox Rd

SUBDIVISION Crestfield BLOCK / SECTION LOT 10 LOT AREA 32604.55 SITE CLASS PS DESIGN FLOW 360 L.T.A.R. .25

Septic Tank: 1000 Gallons; STB 1012 Date 8-24-97

Pump Tank: Gallons; PT Date

Pump Make: Model Serial No.

Nitrification Field: No Fields 4 Square Feet 1080 Linear Feet 360

No Lines 5 Trench Width 36" Max Trench Bottom Depth 36" Gravel Depth N/A

☐ New System ☐ Repair System Type: I II III IV V VI

System Description: Gravity Chambers

Repair System Description: pump to "

Maintenance Agreement Required: ☐ Yes ☐ No

☐ House/Mod. Home ☑ Mobile Home ☐ Business ☐ Other

No. Bedrooms 3 No. Bathrooms 2 No. Employees


Water Supply: ☑ Individual ☐ Community ☐ Public

☐ Slab ☑ Crawl Space ☐ Basement w/plumbing ☐ Basement wo/plumbing


Comments:

Comments: well & Home Not on site at Time of This inspection

INITIAL SITE SKETCH

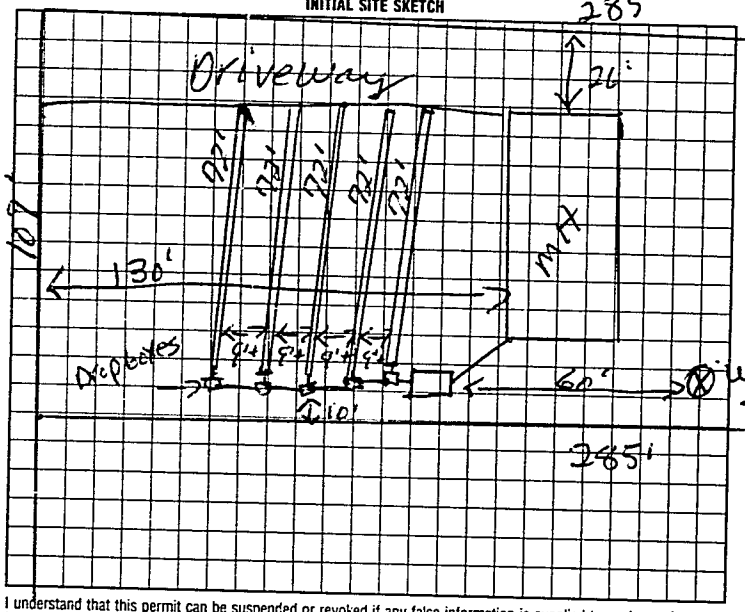


AS BUILT SKETCH

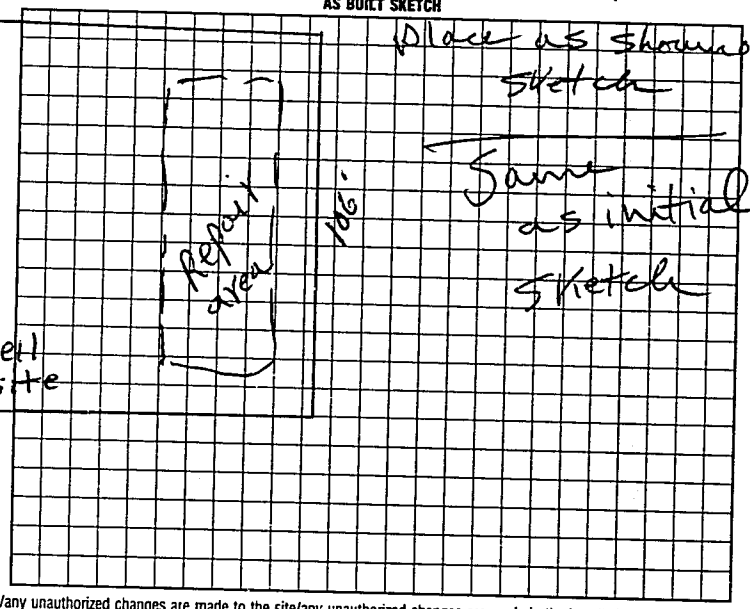


Place as shown on sketch

Same as initial sketch

I understand that this permit can be suspended or revoked if any false information is supplied toward securing the permit/any unauthorized changes are made to the site/any unauthorized changes are made in the installation of the system. Improvement Permit is valid for 60 months from date of issuance.

Signed: Thomas J. Hute

Improvement Permit by: L.C. moore date 7-3-97

Existing System Inspected by: L.C. moore date 7-3-97

Installed by: A-1 Backhoe

Certificate of Completion by: date

Operation Permit by: L.C. moore date 11-17-97

HEALTH DEPT COPY: WHITE INSPECTION COPY (FINAL): GREEN OWNER COPY (FINAL): YELLOW INSPECTION COPY (INITIAL): PINK OWNER COPY (INITIAL): GOLD

Authorization to Const. Expires 60 mos from issue.

to Const.