90426

IREDELL COUNTY HEALTH DEPARTMENT

STATESVILLE 704-878-5305 MOORESVILLE 704-664-5281

IMPROVEMENT PERMIT / CERTIFICATE OF COMPLETION / OPERATION PERMIT / EXISTING SYSTEM INSPECTION

PROPERTY DESCRIPTION NO. 23740 DATE 5-20-96 TAX MAP NO. 5H-1-A-2 Watershed: ☐ Yes ☑ No

OWNER OR CONTRACTOR Margaret Govey PHONE: Business Home 528 0426

ADDRESS 154 Rowan Rd Cleveland, NC. 27013

LOCATION TO E 154 TR Knox Fm Rd 1/4 mi on left

SUBDIVISION Upright Est BLOCK / SECTION 3 LOT LOT AREA 2.04 acres SITE CLASS P5 DESIGN FLOW 360 L.T.A.R. .28

Septic Tank: 1000 Gallons; STB 1012 Date 4-18-00

Pump Tank: Gallons; PT Date

Pump Make: Model Serial No.

Nitrification Field: No Fields 1 Square Feet 1350 Linear Feet 450

No Lines 3 Trench Width 36 Max Trench Bottom Depth 36 Gravel Depth 12"

☑ New System ☐ Repair System Type: I, II, III, IV, V, VI

System Description: Conv. Gravity

Repair System Description:

Maintenance Agreement Required: ☐ Yes ☑ No

☐ House/Mod. Home ☑ Mobile Home ☐ Business ☐ Other

No. Bedrooms 3 No. Bathrooms 2 No. Employees


Water Supply: ☑ Individual ☐ Community ☐ Public

☐ Slab ☑ Crawl Space ☐ Basement w/plumbing ☐ Basement wo/plumbing


Comments:

Comments: Installed as shown

INITIAL SITE SKETCH

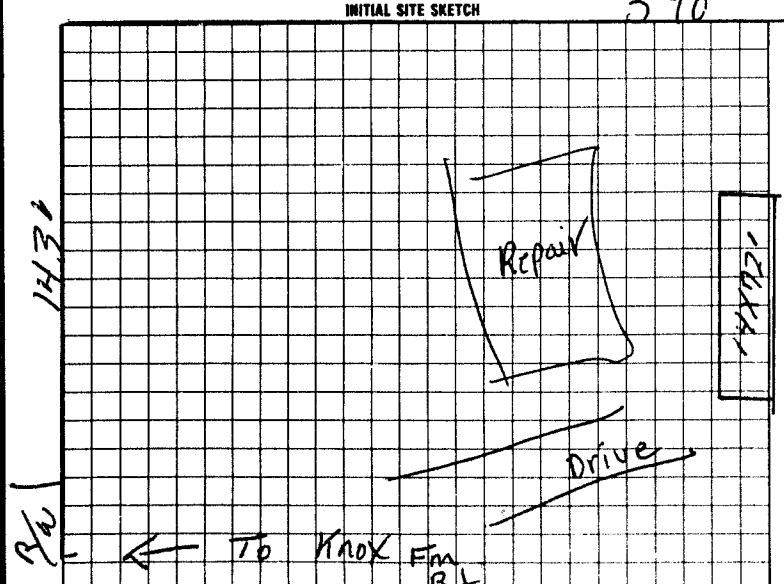

AS BUILT SKETCH

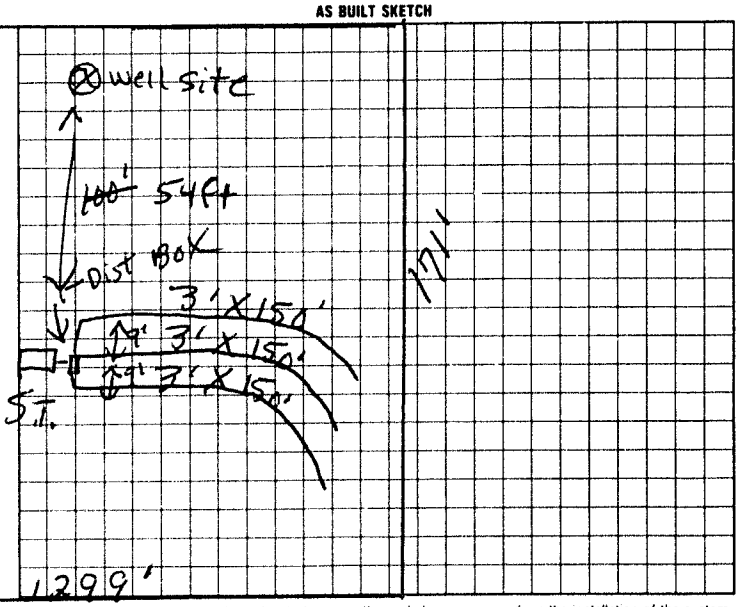

I understand that this permit can be suspended or revoked if any false information is supplied toward securing the permit/any unauthorized changes are made to the site/any unauthorized changes are made in the installation of the system

Signed: X Margaret Govey Installed by Tommy Frye

Improvement Permit by: P.C. Moore date 5-20-96 Certificate of Completion by Tommy Frye date 7-11-00

Existing System Inspected by: Authorization to court P.C. Moore date 5-20-96 Operation Permit by date

HEALTH DEPT. COPY WHITE INSPECTION COPY (FINAL) GREEN OWNER COPY (FINAL) YELLOW INSPECTION COPY (INITIAL) PINK OWNER COPY (INITIAL) GOLD

Authorization to court Expires 60 mos from issue