IREDELL COUNTY HEALTH DEPARTMENT

STATESVILLE 704-878-5305 MOORESVILLE 704-664-5281

IMPROVEMENT PERMIT / AUTHORIZATION TO CONSTRUCT / OPERATION PERMIT / EXISTING SYSTEM INSPECTION

PERMIT# 113742 PIN# 4773-06-1297 DATE 8-25-03

OWNER OR CONTRACTOR JERRY ALFORD PHONE: Business 704-902-0908 Home 704-873-1605

ADDRESS 162 STANEY FARM RD STATESVILLE, NC 28677

LOCATION 70 EAST, (L) ON PAVED DRIVE ACROSS FROM RITCHIE BROS AUCTION

SUBDIVISION _____ BLOCK / SECTION _____ LOT _____ LOT AREA 40.49 AC SITE CLASS. PS DESIGN FLOW 1500 L.T.A.R. .3

Septic Tank: 2250 Gallons; STB 7 Date 5-1-03

Pump Tank: 2250 Gallons; STB 7 Date 5-11-03

Pump Make: Cowles Model WEO 311 M Serial No. 5042476883

Nitrification Field: No Fields 1 Square Feet EQ~~UAL~~ Linear Feet 1253'

No Lines 10X126' Trench Width 36" Max Trench Bottom Depth 36" Gravel Depth N/A

[X] New System [ ] Repair System Type: I, II, (III), IV, V, VI

System Description: PUMP 25% REDUCT

Repair System Description: LP PANEL

Maintenance Agreement Required: [ ] Yes [X] No

[ ] House/Mod. Home No. Bedrooms ____

[ ] Mobile Home No. Bathrooms ____

[X] Business No. Employees 60

[ ] Other 60 EMPLOYEE'S


[X] Slab [ ] Crawl Space [ ] Basement w/plumbing [ ] Basement wo/plumbing

Water Supply: [ ] Individual [X] Public [ ] Community


Comments/Conditions: (1) TANK SIZES ARE MINIMUM GALLONS OF STORAGE, MAY USE LARGER TANKS. (2) SYSTEM IS FLAGGED OUT COMPLETELY (3) MAINTAIN SETBACKS (4) INSTALL 10 LINES 126' LONG USING 25% REDUCTION

Comments/Conditions: + A PRESSURE MANIFOLD, (5) SYSTEM IS FLAGGED OUT ENTIRELY, (6) CRUSH + FILL OLD SEPTIC TANK, (7) TIE INTO EXISTING SUPPLY LINE FROM THE BUILDING

INITIAL SITE SKETCH

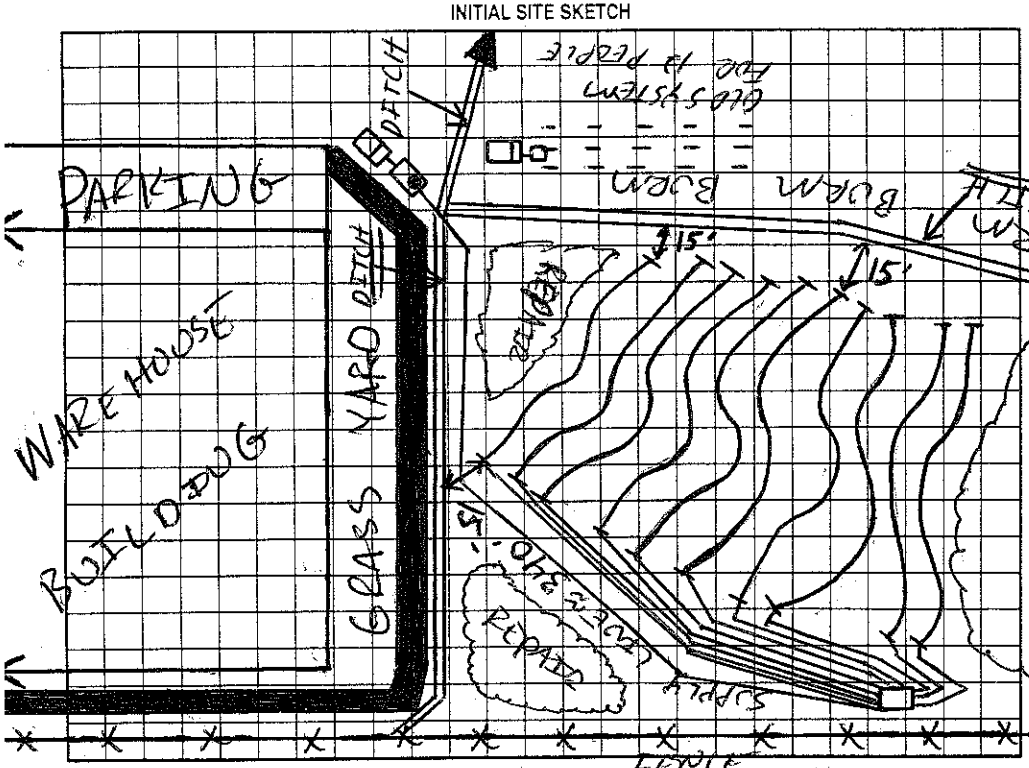

AS BUILT SKETCH

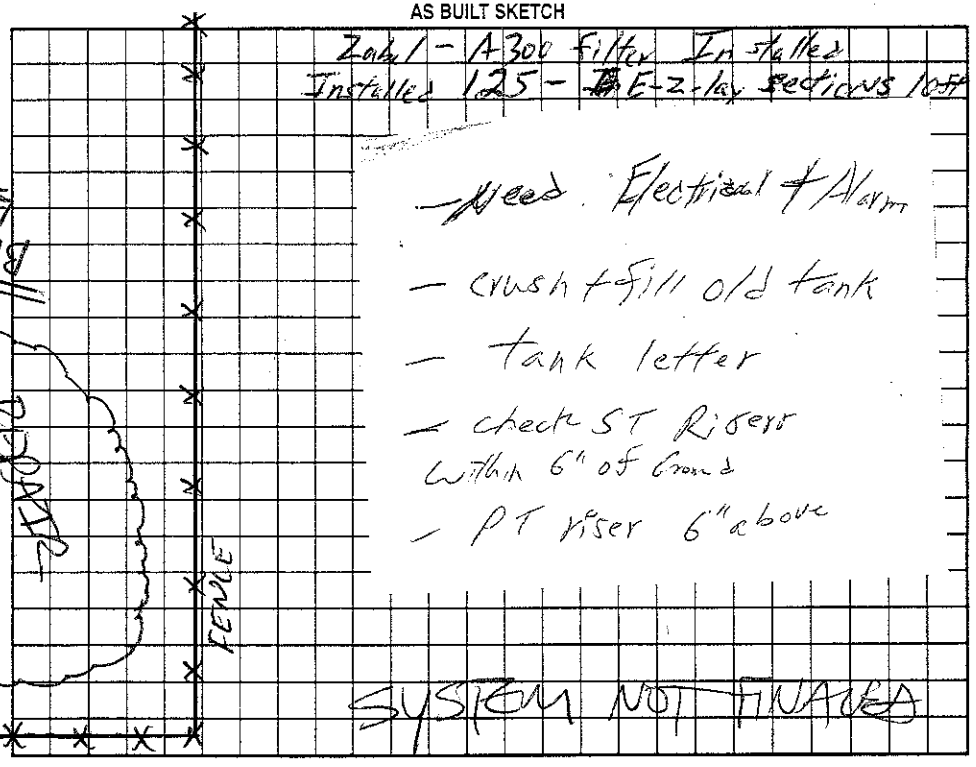

Permit can be suspended or revoked if any false information is supplied toward securing the permit/any unauthorized changes are made to the site/any unauthorized changes are made in the installation of the system. Improvement Permit with ~~plat~~ valid without expiration. Improvement Permit with site plan valid for sixty months. Authorization to Construct is valid for a period equal to that of Improvement Permit – not to exceed sixty months.

Signed: _____ date 8-25-03 Installed by: Marty Tucker (10/23/03)

Improvement Permit by: _____ RS date 8-25-03 Operation Permit by: EH North date 8-24-08

Authorization to ~~Construct~~ by: _____ RS date 8-25-03 Existing System Inspection by: _____ date _____

HEALTH DEPT. COPY: WHITE OWNER COPY (FINAL): YELLOW OWNER COPY (INITIAL): PINK