(CI) * THIS PERMIT REPLACES PREVIOUS PERMIT, ISSUED ON 09/10/03.

IREDELL COUNTY HEALTH DEPARTMENT

STATESVILLE 704-878-5305 MOORESVILLE 704-664-5281

IMPROVEMENT PERMIT / AUTHORIZATION TO CONSTRUCT / OPERATION PERMIT / EXISTING SYSTEM INSPECTION

PERMIT# 136769 PIN# 4773-21-5474 DATE 07/12/06

OWNER OR APPLICANT CYNTHIA HELMIC PHONE: Business 704-873-3057 Home 704-450-2725

ADDRESS 236 TRIPLETT RD, CLEVELAND, NC 27013

LOCATION HWY 70 E., (R) BUSINESS PRK DR., (L) OPPORTUNITY DR., (R) PROGRESS PL., @ END OF ROAD TAKE LONG DRIVE @ END.

SUBDIVISION N/A BLOCK / SECTION — LOT — LOT AREA 56,587 Ac. SITE CLASS. PS DESIGN FLOW 360 GPD L.T.A.R. 0.25 GPD/FT²

Septic Tank: 1,000 Gallons; STB Dillengr 500/714 1000 Date 9-11-06
Pump Tank: ____ Gallons; PT ____ Date ____
Pump Make: ____ Model ____ Serial No. ____
Nitrification Field: No Fields 1 Square Feet 1,440 Linear Feet 480
No Lines 4@120' Trench Width 36" Max Trench Bottom Depth 36"

[X] New System [ ] Repair [ ] Expansion System Type: I II III IV V VI (II)
System Description: CONVENTIONAL, GRAVITY
Repair System Description: CONVENT., GRAVITY
Maintenance Agreement Required: [ ] Yes [X] No

[X] House/Mod. Home No. Bedrooms 3
[ ] Mobile Home No. Persons ____
[ ] Business No. Employees ____
[ ] Other ____


Water Supply: [X] Individual WELL [ ] Public [ ] Community

Gravel Depth 12" [X] Gravity [ ] Pressure [ ] Slab [ ] Crawl Space [ ] Basement w/plumbing [X] Basement wo/plumbing

Comments/Conditions: (1) POOL MUST BE 15'+ FROM ANY PART OF SEPTIC OR REPAIR AREA. (2) HOME OWNER REQUEST RISERS BE PLACED ON THE SEPTIC TANK. (3) DO NOT GRADE OR DISTURB SEPTIC AREA. (4) SEPTIC MUST BE 15'+ FROM BASEMENT FOUNDATION.

* AN "APPROVED" SYSTEM MAY ALSO BE USED.

INITIAL SITE SKETCH

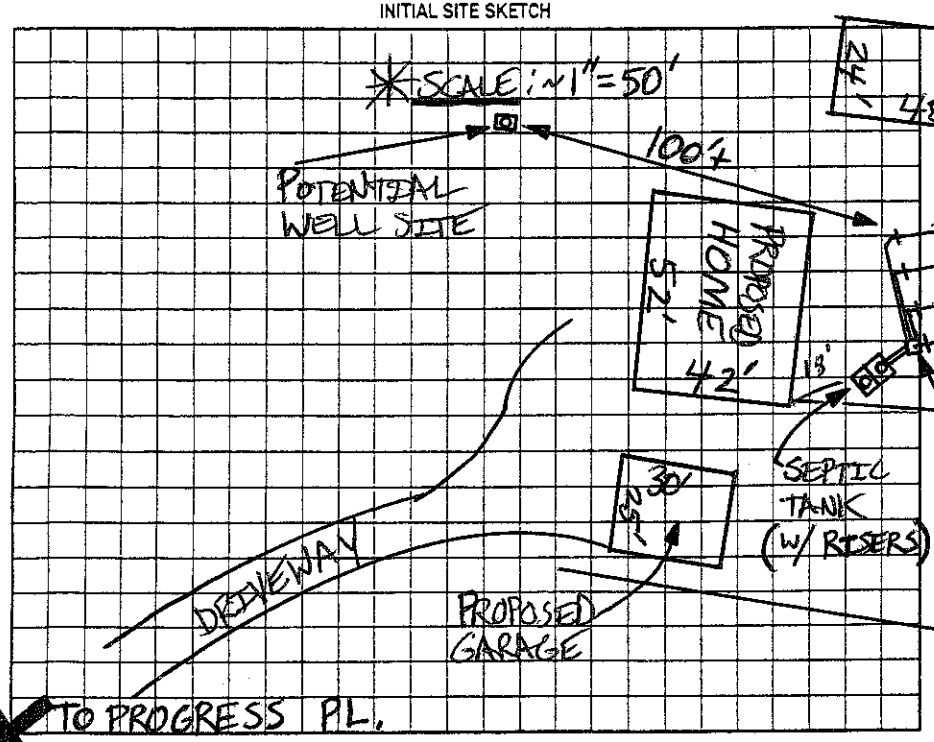


AS BUILT SKETCH

* Filter installed

Quick-Fit + inline

Risers > 6" above surface.

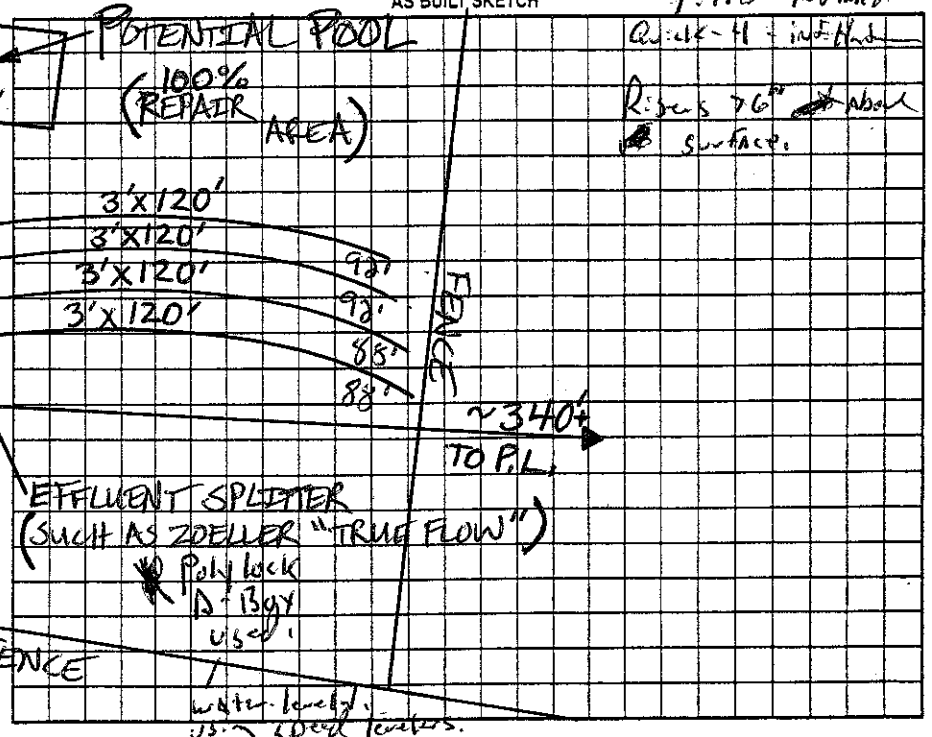

Permit can be suspended or revoked if any false information is supplied toward securing the permit/any unauthorized changes are made to the site/any unauthorized changes are made in the installation of the system. Improvement Permit with plat valid without expiration [ ] Improvement Permit with site plan valid for sixty months [X] Authorization to Construct is valid for a period equal to that of Improvement Permit – not to exceed sixty months.

Signed: Cynthia D Helmic date 8-2-06

Improvement Permit by: Patrick Pritchett date 07/12/06

Authorization to Construct by: Patrick Pritchett date 07/12/06

Installed by: Stanley Spitz

Operation Permit by: Jim Noggle, R.S. date 12 Dec. 06

Existing System Inspection by: ____ date ____

HEALTH DEPT. COPY: WHITE OWNER COPY (FINAL): YELLOW OWNER COPY (INITIAL): PINK