IREDELL COUNTY HEALTH DEPARTMENT

STATESVILLE 704-878-5305 MOORESVILLE 704-664-5281

IMPROVEMENT PERMIT / AUTHORIZATION TO CONSTRUCT / OPERATION PERMIT / EXISTING SYSTEM INSPECTION

PERMIT# 97004 PIN# 4773308260 3487 DATE 2-15-08

OWNER OR APPLICANT SANDY GROSS PHONE: Business 704-528-1303 Home

ADDRESS 138 Sweetbriar LN Statesville NC 28160

LOCATION 70E TO TURNER RD Travis FARM RD

SUBDIVISION BLOCK / SECTION LOT LOT AREA 19.2 SITE CLASS B DESIGN FLOW 300 L.T.A.R. 125

Septic Tank: 1000 Gallons; STB 750 Date 2-14-08

Pump Tank: 1000 Gallons; PT 343 Date 3-23-08

Pump Make: Zoeller Model 151-5058 Serial No. Unsure

Nitrification Field: No Fields 1 Square Feet 1440 Linear Feet 300

No Lines 4 Trench Width 36" Max Trench Bottom Depth 30" Gravel Depth 24

☒ New System ☐ Repair ☐ Expansion System Type: I II III IV V VI

System Description: 25% Pump Pressure

Repair System Description: 25% pump Pressure

Maintenance Agreement Required: ☐ Yes ☒ No

☒ House/Mod. Home ☐ Mobile Home ☐ Business ☐ Other

No. Bedrooms 3 No. Persons No. Employees

Water Supply: ☐ Individual ☐ Public ☐ Community

☐ Gravity ☒ Pressure ☐ Slab ☒ Crawl Space ☐ Basement w/plumbing ☐ Basement wo/plumbing


Comments:/Conditions:

Around ductile iron 6" Sewer after culverted stream 10' on each side


Comments:/Conditions:

Install on contour Maintain all setbacks

INITIAL SITE SKETCH

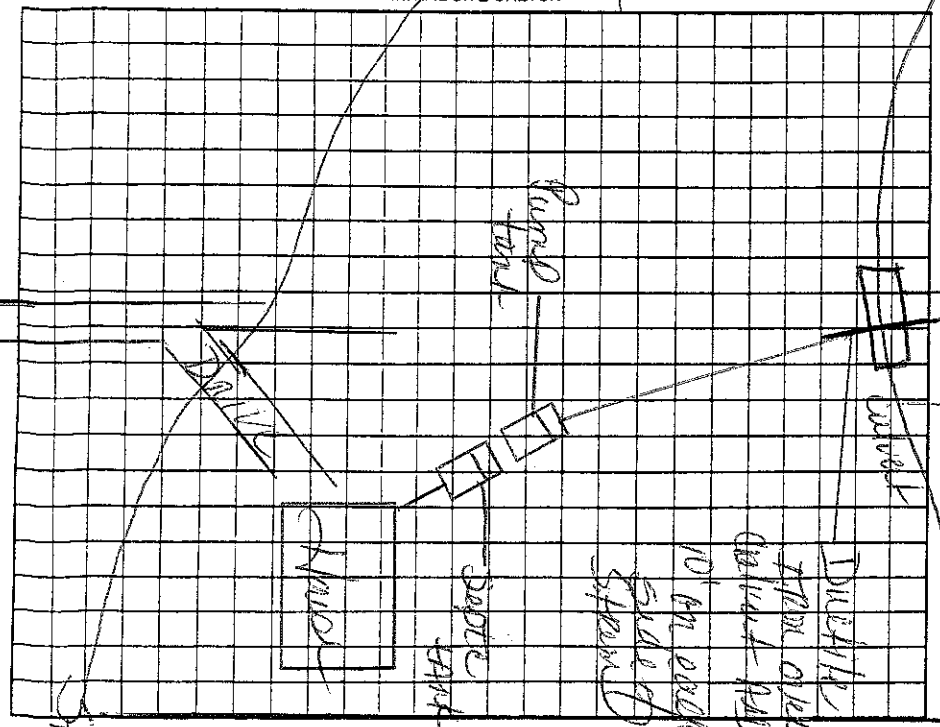

AS BUILT SKETCH

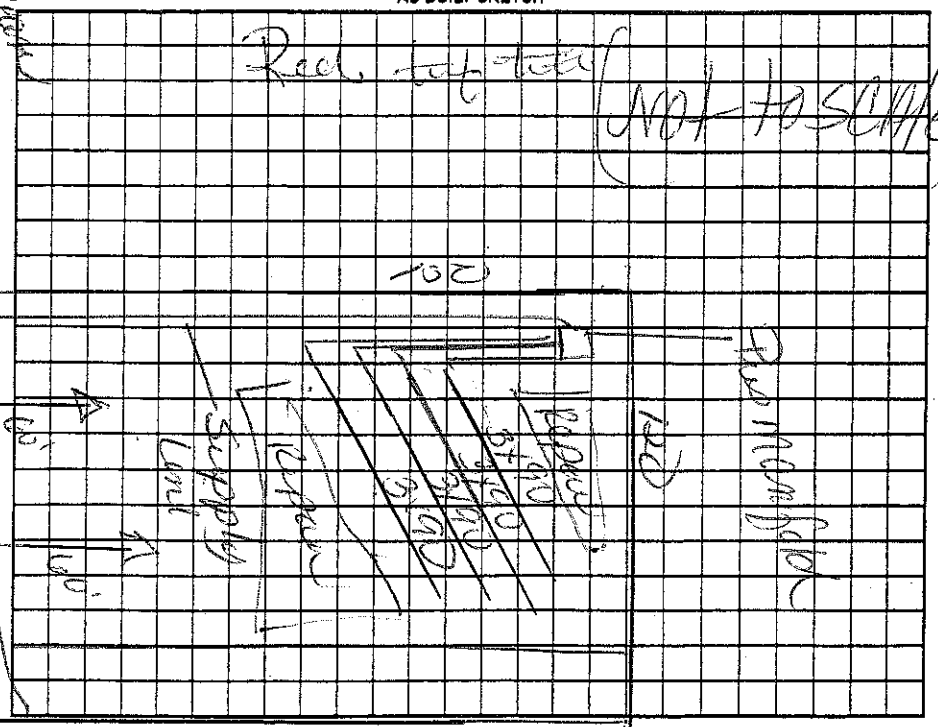

Permit can be suspended or revoked if any false information is supplied toward securing the permit/any unauthorized changes are made to the site/any unauthorized changes are made in the installation of the system. Improvement Permit with plat valid without expiration ☐ Improvement Permit with site plan valid for sixty months ☒ Authorization to Construct is valid for a period equal to that of Improvement Permit – not to exceed sixty months.

Signed: Mike Cox date 2-15-08 Installed by: Hoey Cooper

Improvement Permit by: Kelly Cook date 2-15-08 Operation Permit by: Kelly Cook date 6-26-08

Authorization to Construct by: Kelly Cook date 2-15-08 Existing System Inspection by: date

HEALTH DEPT. COPY: WHITE OWNER COPY (FINAL): YELLOW OWNER COPY (INITIAL): PINK

Beaus Ground