IREDELL COUNTY HEALTH DEPARTMENT

STATESVILLE 704-878-5305 MOORESVILLE 704-664-5281

IMPROVEMENT PERMIT / AUTHORIZATION TO CONSTRUCT / OPERATION PERMIT / EXISTING SYSTEM INSPECTION

PERMIT# 47044 PIN# 4773308260 3487 DATE 2-15-08

OWNER OR APPLICANT SANDY GROSS PHONE: Business 704-528-1303 Home

ADDRESS 138 Serendipity LN Troutman NC 28166

LOCATION 70E GR TROUTMAN @ Bevins Farm RD

SUBDIVISION BLOCK / SECTION LOT LOT AREA 19.2 SITE CLASS. PS DESIGN FLOW 360 L.T.A.R. .125

Septic Tank: 1000 Gallons; STB 750 Date 2-16-08
Pump Tank: 1000 Gallons; PT 363 Date 5-23-08
Pump Make: Zoeller Model 151-0006 Serial No. Un-504
Nitrification Field: No Fields 1 Square Feet 1440 Linear Feet 360
No Lines 4 Trench Width 36" Max Trench Bottom Depth 30"

☑ New System ☐ Repair ☐ Expansion System Type: I II III IV
System Description: 25% Dam PM
Repair System Description: 25% pump PM
Maintenance Agreement Required: ☐ Yes ☑ No
Gravel Depth NA ☐ Gravity ☑ Pressure


☑ House/Mod Home ☐ Mobile Home ☐ Business ☐ Other
No. Bedrooms 3 No. Persons No. Employees
Water Supply: ☐ Individual ☐ Public ☐ Community

☐ Slab ☑ Crawl Space ☐ Basement w/plumbing ☐ Basement wo/plumbing

Comments:/Conditions:
Insure ductile iron over culverted streams 10' on each side

Comments:/Conditions:
Install on contour. Maintain all setbacks

INITIAL SITE SKETCH

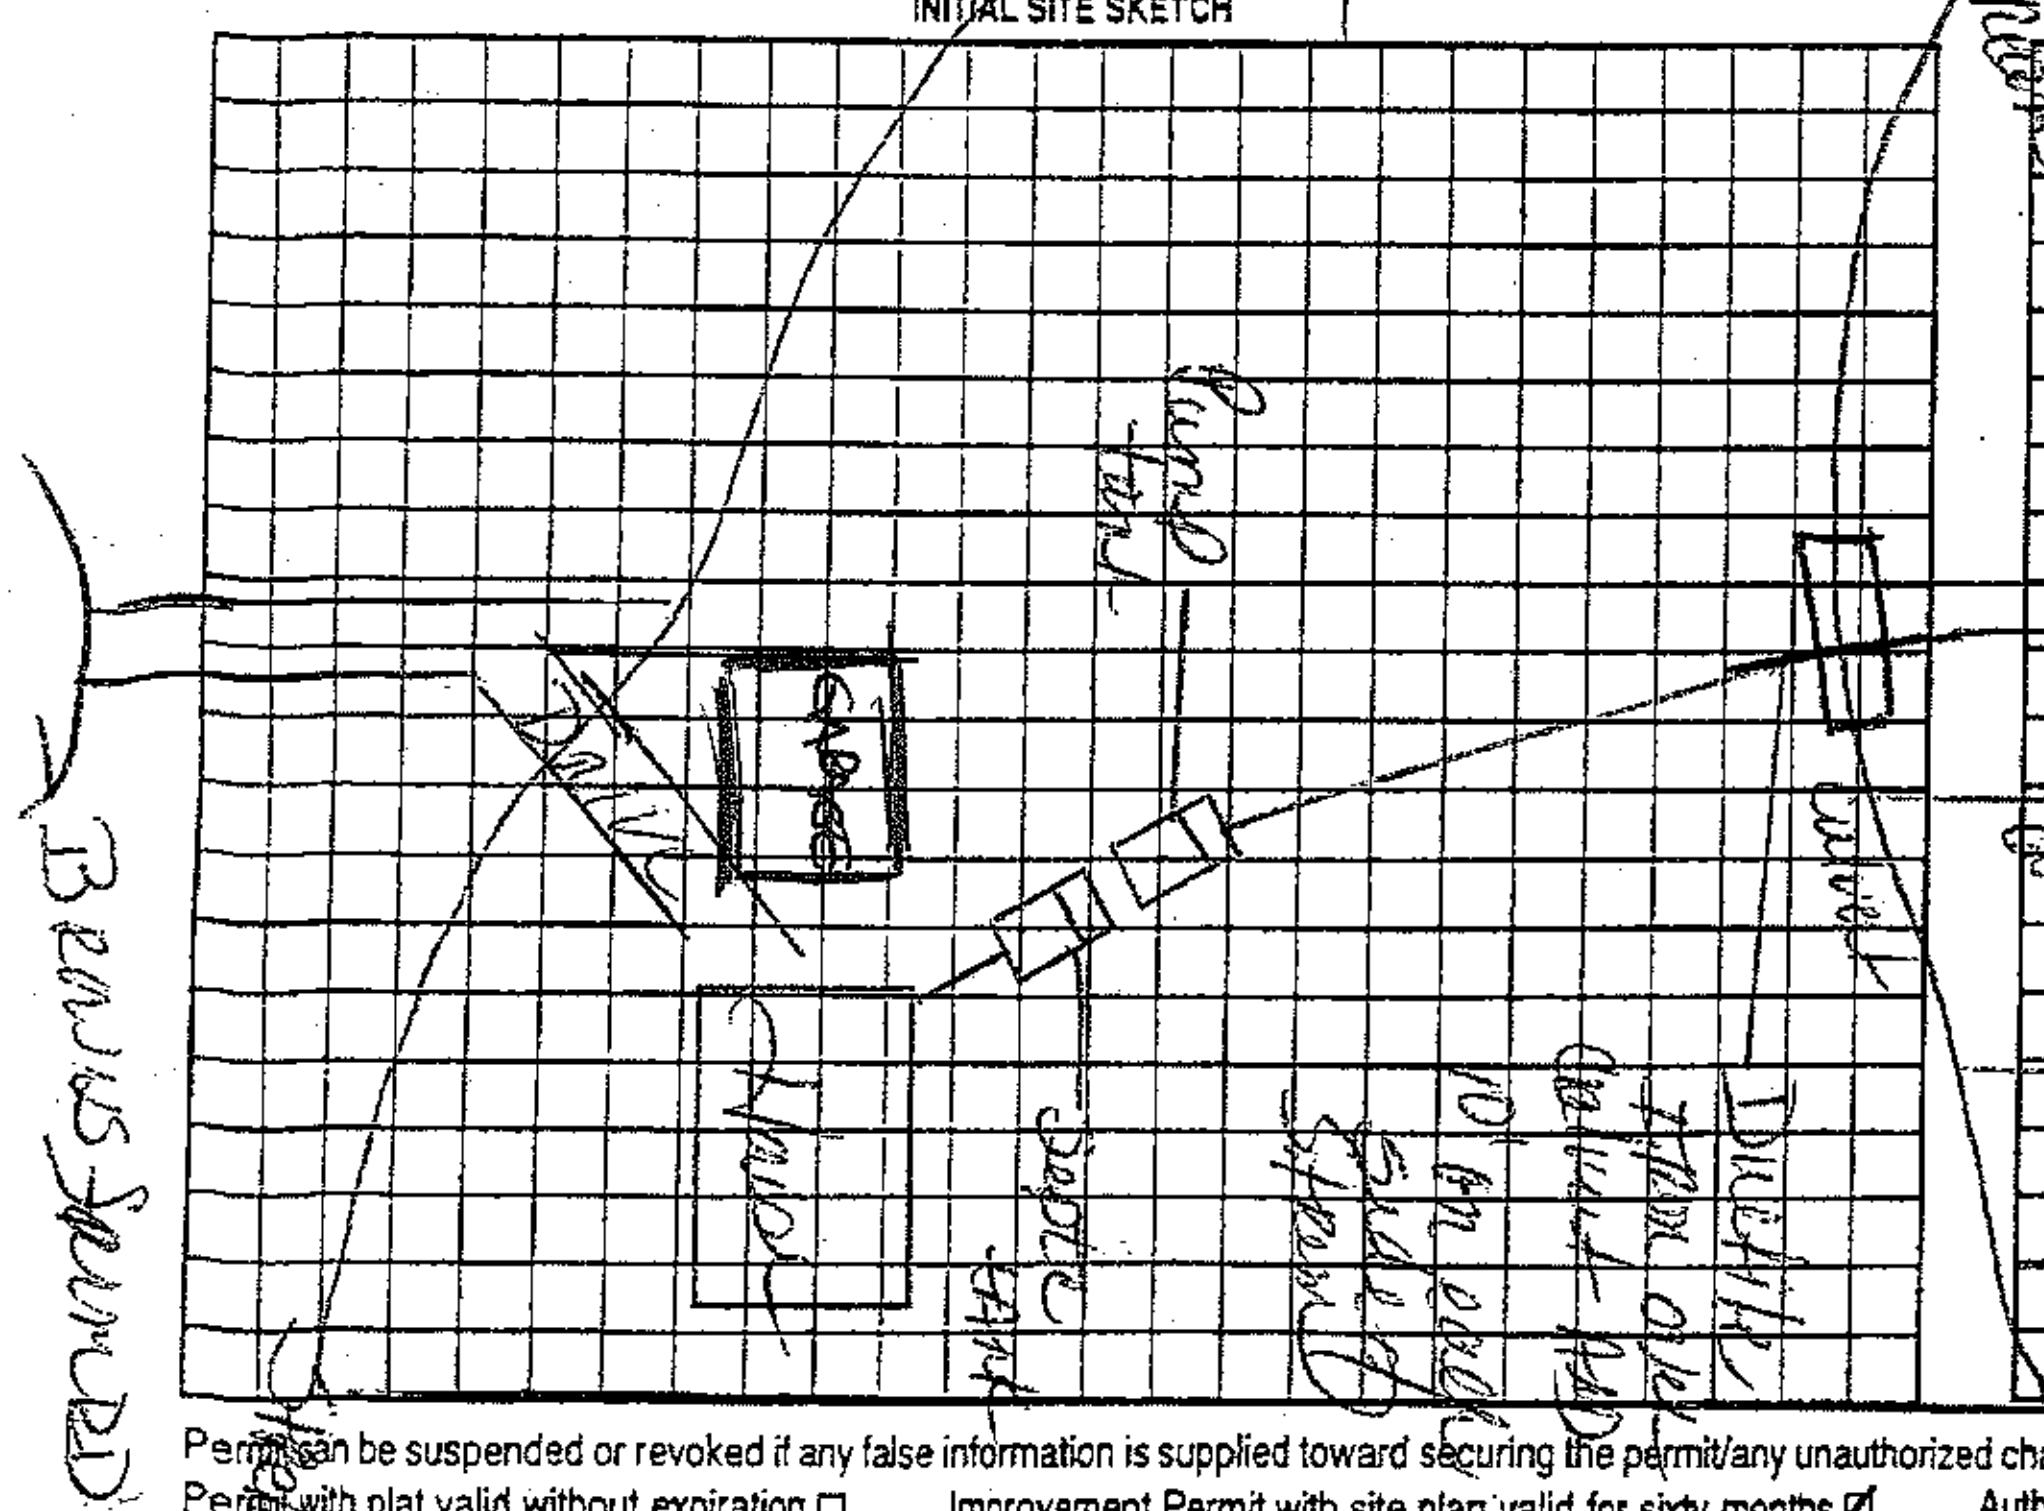


AS BUILT SKETCH

Location of the proposed ____ addition does not appear to impact the existing on-site septic system.NOTE:**

R. STEVE HEDRICK REHS

Date: 12 / 12 / 2012

ICHD-Environmental Health Division

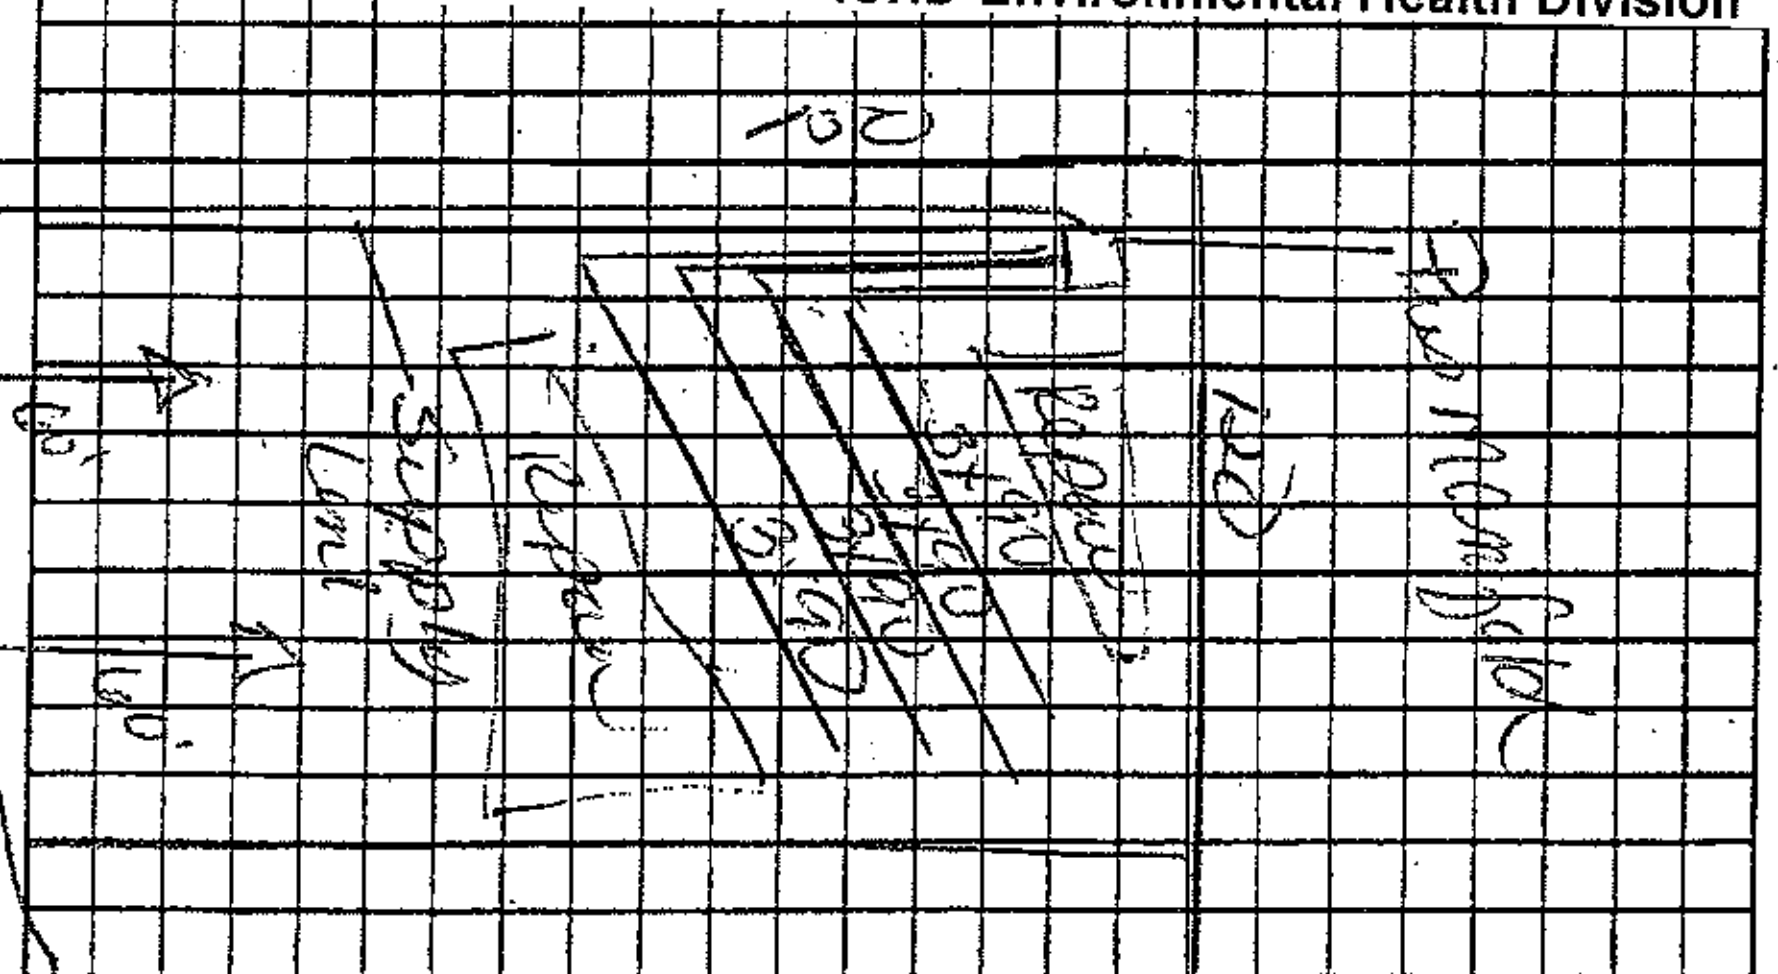

Permit can be suspended or revoked if any false information is supplied toward securing the permit/any unauthorized changes are made to the site/any unauthorized changes are made in the installation of the system. Improvement Permit with plat valid without expiration ☐ Improvement Permit with site plan valid for sixty months ☑ Authorization to Construct is valid for a period equal to that of Improvement Permit – not to exceed sixty months.

Signed: Mike Gross date 2-15-08 Installed by: Above Grading

Improvement Permit by: Kelly Cook date 2-15-08 Operation Permit by: Kelly Cook date 6-26-08

Authorization to Construct by: Kelly Cook date 2-15-08 Existing System Inspection by: date

HEALTH DEPT. COPY: WHITE OWNER COPY (FINAL): YELLOW OWNER COPY (INITIAL): PINK