IREDELL COUNTY HEALTH DEPARTMENT

STATESVILLE 704-878-5305 MOORESVILLE 704-664-5281

IMPROVEMENT PERMIT / AUTHORIZATION TO CONSTRUCT / OPERATION PERMIT / EXISTING SYSTEM INSPECTION

PERMIT# 150955 PIN# 4773906097 DATE 6-2-08

OWNER OR APPLICANT Freedom Homes PHONE: Business Home 704-872 0179

ADDRESS 270 Northside Dr Statesville NC 28625

LOCATION 70E @ Turnpike (R) Brown Farm Rd Lot on Lft

SUBDIVISION Brown Farms BLOCK / SECTION 3 LOT 21 LOT AREA .914 SITE CLASS. 05 DESIGN FLOW 480 L.T.A.R. .3

Septic Tank: 1000 Gallons: STB 1012 Date 12-11-01

Pump Tank: _____ Gallons: PT _____ Date _____

Pump Make: _____ Model _____ Serial No. _____

Nitrification Field: No Fields ___ Square Feet 1600 Linear Feet 480

No Lines 6 X 70 Trench Width 36" Max Trench Bottom Depth 30" Gravel Depth N/A

☑ New System ☐ Repair ☐ Expansion System Type: I II III IV V VI

System Description: 25% Reduction Capacity

Repair System Description: 50% Reduction Pump

Maintenance Agreement Required: ☐ Yes ☑ No

☐ Gravity ☐ Pressure

☐ House/Mod. Home No. Bedrooms 4

☑ Mobile Home No. Persons ___

☐ Business No. Employees ___

☐ Other ___


Water Supply: ☑ Individual ☐ Public ☐ Community

☐ Slab ☑ Crawl Space ☐ Basement w/plumbing ☐ Basement wo/plumbing


Comments:/Conditions:

Comments:/Conditions:

INITIAL SITE SKETCH

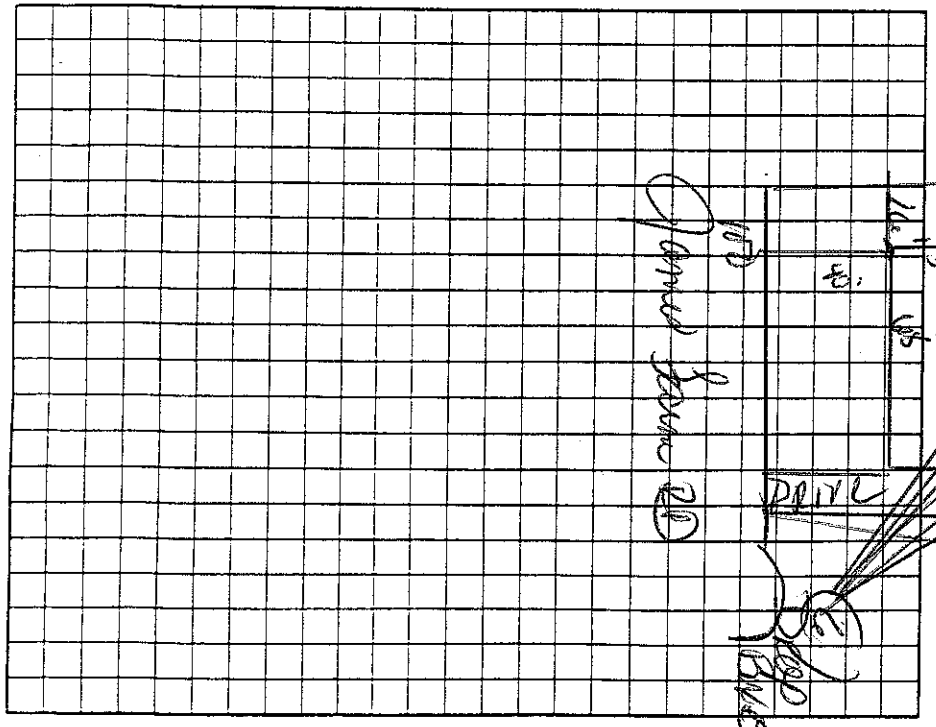

AS BUILT SKETCH

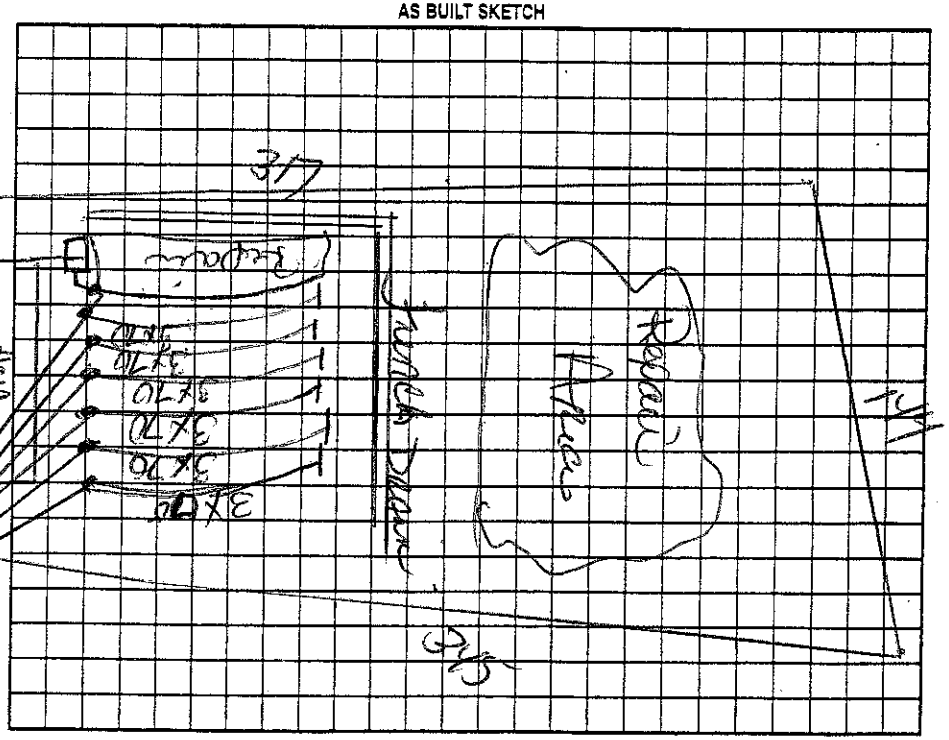

Permit can be suspended or revoked if any false information is supplied toward securing the permit/any unauthorized changes are made to the site/any unauthorized changes are made in the installation of the system. Improvement Permit with plat valid without expiration ☐ Improvement Permit with site plan valid for sixty months ☑ Authorization to Construct is valid for a period equal to that of Improvement Permit – not to exceed sixty months.

Signed: _____ date _____ Installed by: A-1 Backhoe

Improvement Permit by: _____ date _____ Operation Permit by: _____ date _____

Authorization to Construct by: _____ date _____ Existing System Inspection by: _____ date 6-12-8

HEALTH DEPT. COPY: WHITE OWNER COPY (FINAL): YELLOW OWNER COPY (INITIAL): PINK