IREDELL COUNTY HEALTH DEPARTMENT

STATESVILLE 704-878-5305 MOORESVILLE 704-664-5281

IMPROVEMENT PERMIT / AUTHORIZATION TO CONSTRUCT / OPERATION PERMIT / EXISTING SYSTEM INSPECTION

PERMIT# 109373 PIN# ~~4772-39-5418.23~~ 4773-50-0358 DATE 10-24-02

OWNER OR CONTRACTOR RAY BENGE PHONE: Business (704) 838-1429 Home

ADDRESS 1214 ISLAND FORD ROAD STATESVILLE NC 28625

LOCATION US 70 EAST TR TRIPLETT ROAD, TR BROWN FARMS DRIVE, 8TH LOT ON RIGHT

SUBDIVISION J.R. BROWN FARMS BLOCK / SECTION III LOT 23 LOT AREA 0.698 ACRE SITE CLASS. PS DESIGN FLOW 360 L.T.A.R. 0.25 GPD/FT²

Septic Tank: 1000 Gallons; STB 1012 Date 08/30/02

Pump Tank: ____ Gallons; PT ____ Date ____

Pump Make: ____ Model ____ Serial No. ____

Nitrification Field: No Fields 1 Square Feet Eq. to 1440 Linear Feet 240

No Lines EIGHT Trench Width 24" Max Trench Bottom Depth 36" ~~Gravel~~ Depth SAND 6"

☑ New System ☐ Repair System Type: I, II, III, IV, V, VI

System Description: 50% REDUCTION, GRAVITY

Repair System Description: 50% REDUCTION, LOW PRESSURE

Maintenance Agreement Required: ☐ Yes ☑ No

☐ House/Mod. Home ☑ Mobile Home ☐ Business ☐ Other

No. Bedrooms 3 No. Bathrooms 2 No. Employees ____


☐ Slab ☐ ~~Crawl~~ Space ☐ Basement w/plumbing ☐ Basement wo/plumbing

Water Supply: ☑ Individual ☐ Public ☐ Community WELL


Comments:/Conditions: ① FILL EXISTING GULLY AS SHOWN. ② INSTALL 50% REDUCTION SYSTEM USING FIFTY-SIX (56) PPBPS PANELS AS SHOWN.

Comments:/Conditions: -SEPTIC TANK INSTALLED USING TUFF-TIGHT FILTER. *SYSTEM INSTALLED DURING MOIST SOIL CONDITIONS.*

INITIAL SITE SKETCH

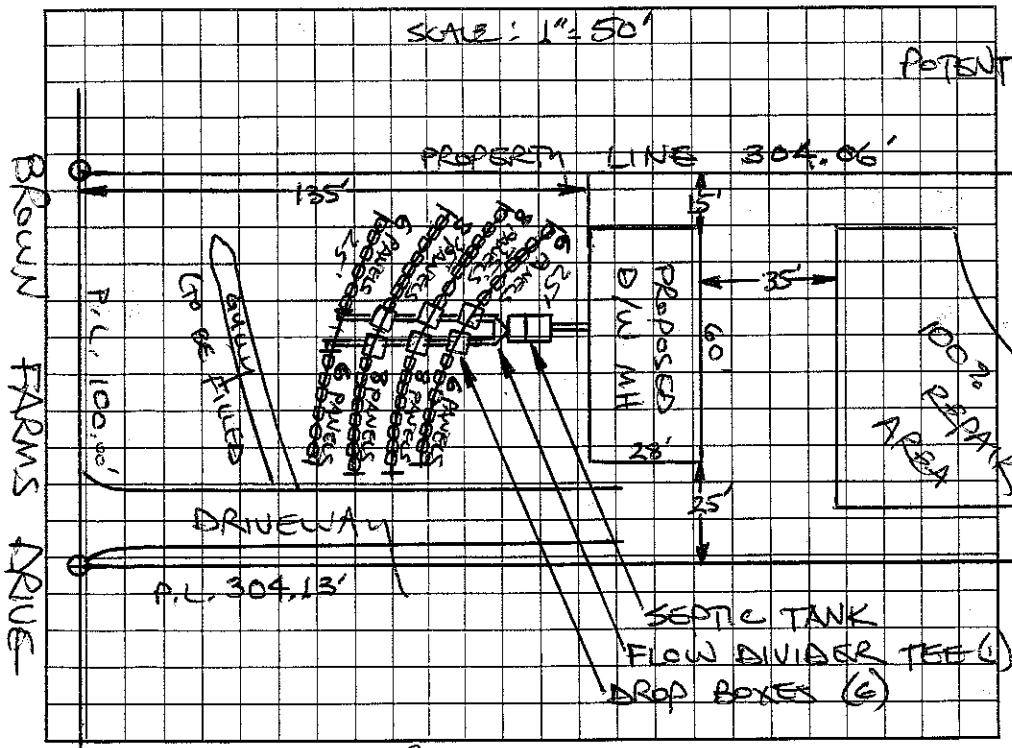

AS BUILT SKETCH

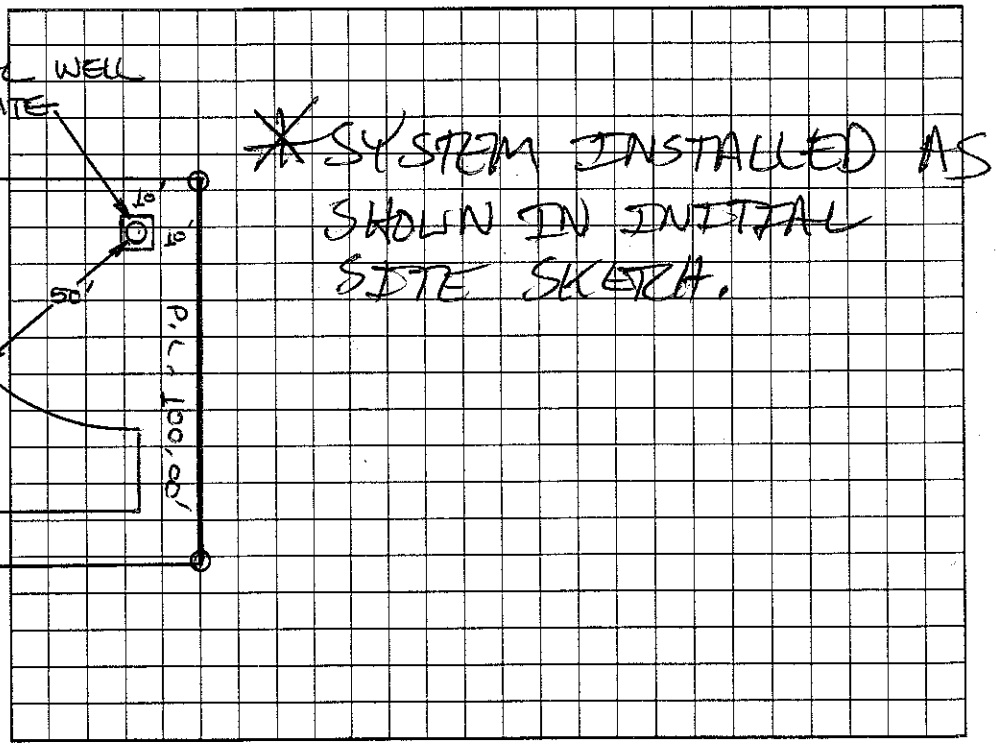

Permit can be suspended or revoked if any false information is supplied toward securing the permit/any unauthorized changes are made to the site/any unauthorized changes are made in the installation of the system. Improvement Permit with plat valid without expiration. Improvement Permit with site plan valid for sixty months. Authorization to Construct is valid for a period equal to that of Improvement Permit – not to exceed sixty months.

Signed: ____ date 11-5-02 Installed by: A-1 BACKHOE 5-8-03

Improvement Permit by: STEVE HENDRICK date 10-24-02 Operation Permit by: Patrick Mitchell date 05/08/03

Authorization to Construct by: STEVE HENDRICK date 10-24-02 Existing System Inspection by: ____ date ____

HEALTH DEPT. COPY: WHITE OWNER COPY (FINAL): YELLOW OWNER COPY (INITIAL): PINK