IREDELL COUNTY HEALTH DEPARTMENT

Statesville Office (704) 878-5305 Mooresville Office (704) 660-3625 PERMIT # 22143

IMPROVEMENT PERMIT / AUTHORIZATION TO CONSTRUCT / OPERATION PERMIT / EXISTING SYSTEM

PIN # 4773503012 ✓

APPLICANT: Jerry Brown APPLICANT ADDRESS: 1124 Charlotte Hwy Troutman NC

SITE ADDRESS: 131 Brown Farms Dr, Cleveland, NC PHONE: ALT. PHONE: 704-528-7860

SITE DIRECTIONS: 115 N - TR OSWALT ANITY - TL TREPLETTE - TL BROWN FARM DR - ON LT

SUBDIVISION: ✓ J.R. BROWN FARMS SECTION: 2 LOT # 15 LOT AREA: ~.6 AC DESIGN FLOW: 360 L.T.A.R.: .275

Septic Tank 1000 (gal) STB 760 Date 7/15/16 — ☑ New System ☐ Repair ☐ Expansion System Type: I II III IV V VI — ☑ Residence No. Bedrooms 3 — Water Supply: ☑ Private

Pump Tank (gal) PT Date — System Description: GRAVITY 75% REDUCTION — ☐ Business No. Persons 6 — ☐ Public

Pump Make Model Serial # — Repair System Description: PUMP 75% REDUCTION — ☐ Other No. Employees — ☐ Community

Nitrification Fields 1 # Lines 4 Linear Ft: 328 — Maintenance Agreement Required: ☐ YES ☑ NO — ☐ Slab ☑ Crawl Space

Trench Width 36" Max. Trench Bottom Depth (24.33" low) Gravel Depth N/A — ☑ GRAVITY ☐ PRESSURE — ☐ Basement w/plumbing ☐ Basement w/o plumbing

Comments / Conditions:

9/1/16 Reviewed floor plans, in Compliance with Septic plan.

INITIAL SITE SKETCH

See Carolina Soil & Septic Consulting's Design

AS BUILT SKETCH

Permit can be suspended or revoked if any false information is supplied toward securing the permit / any unauthorized changes are made to the site / any unauthorized changes are made in the installation of the system. **CONTACT A LOCATOR SERVICE PRIOR TO ANY EXCAVATION**

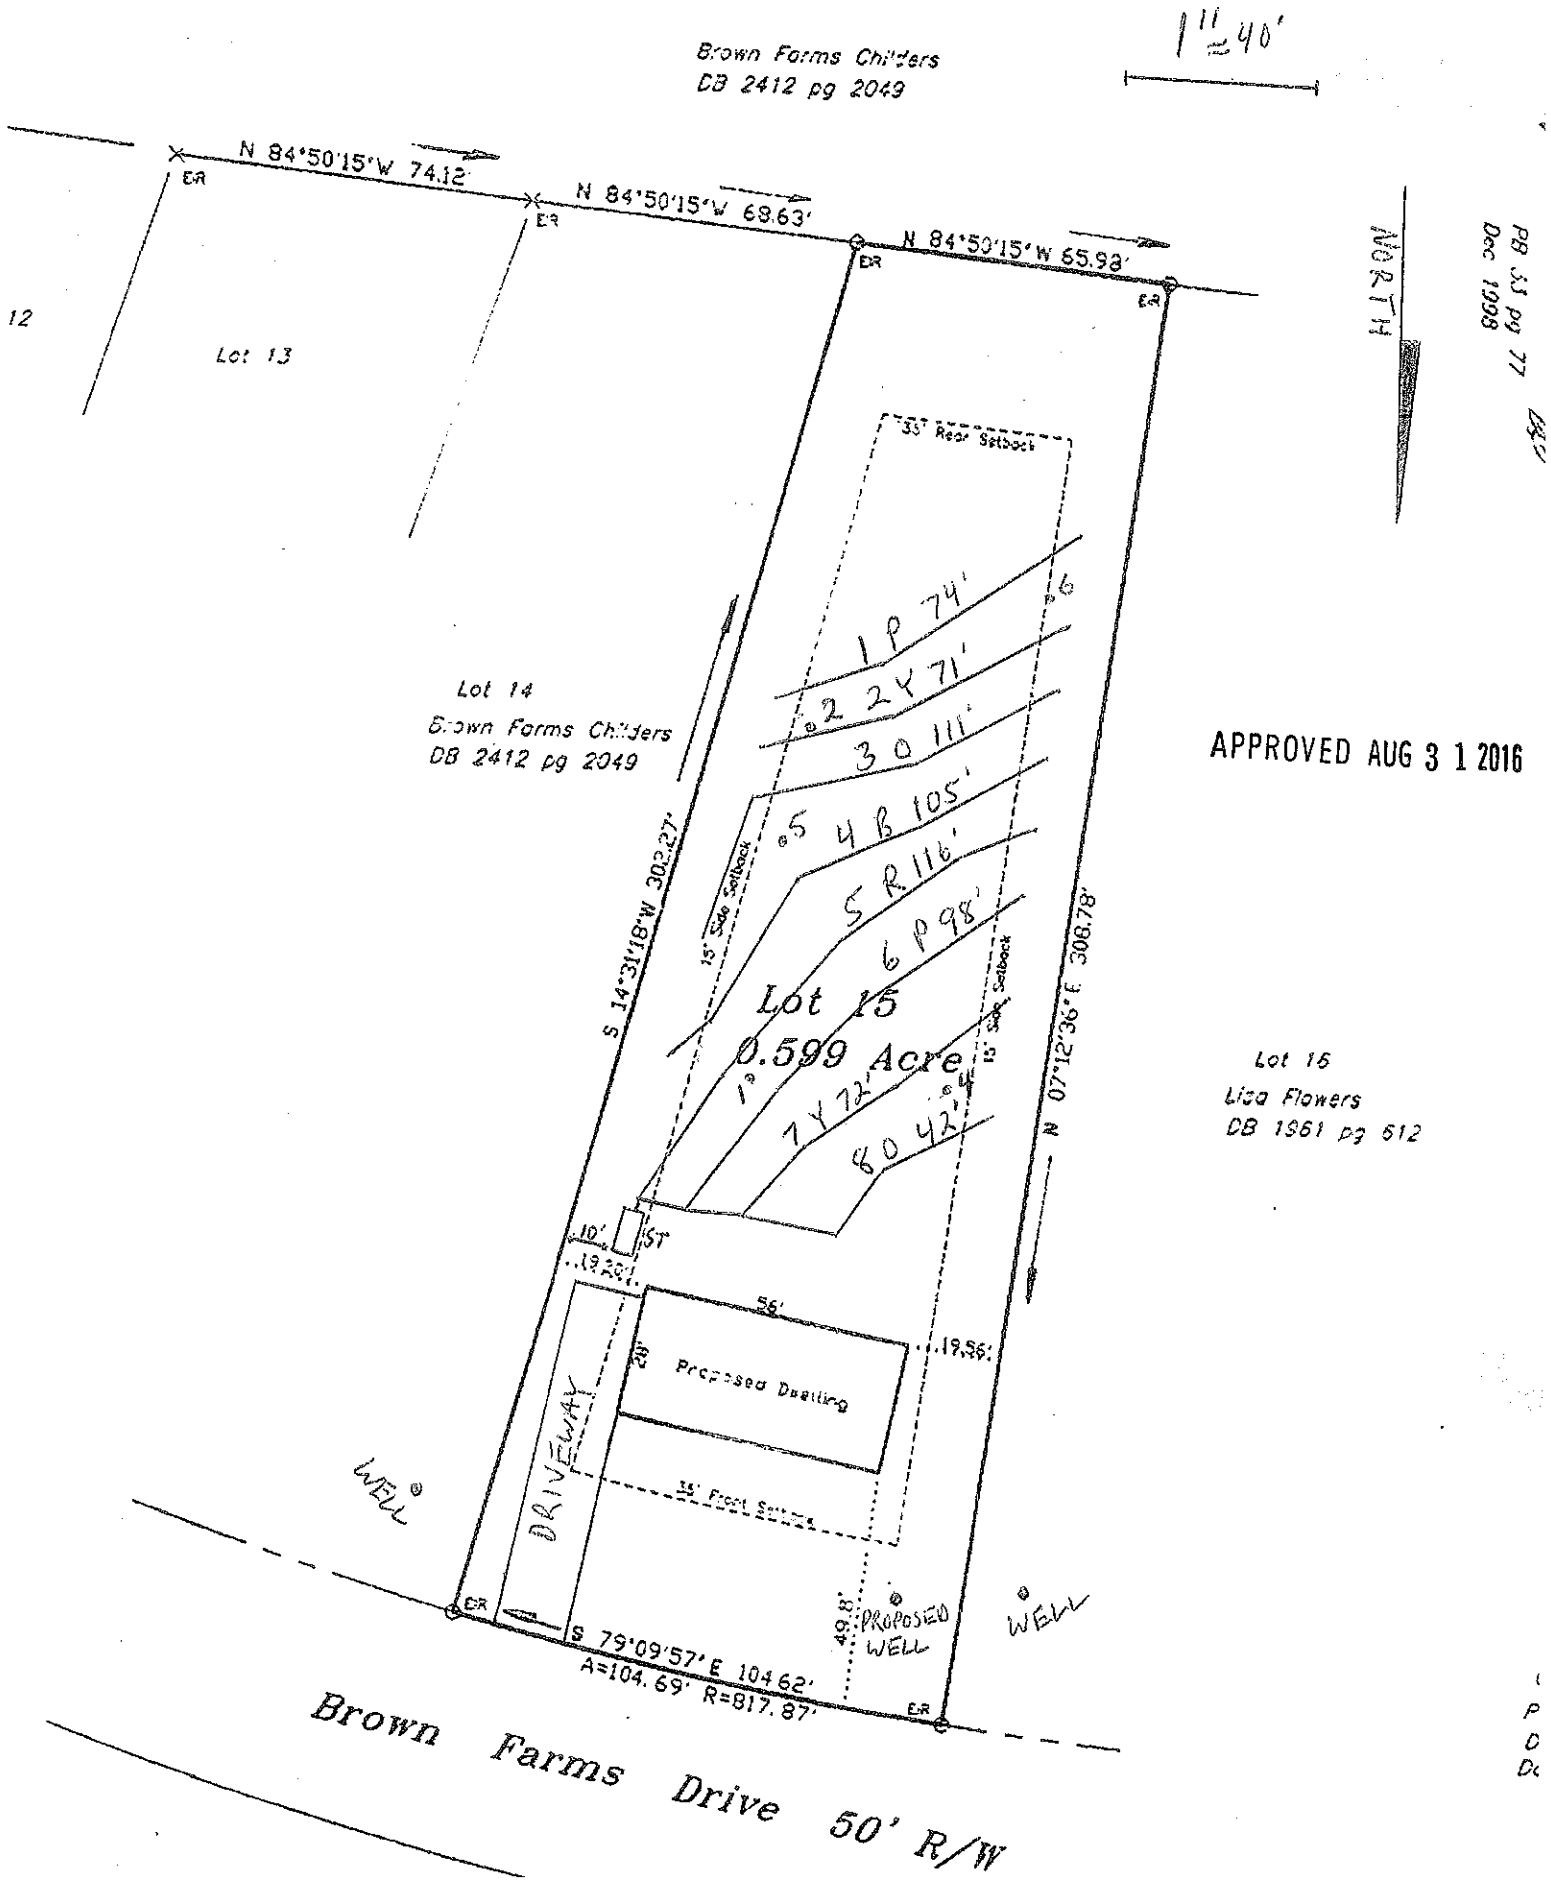
☐ **IMPROVEMENT PERMIT** *with plat valid without expiration.* ☐ **IMPROVEMENT PERMIT** *with site plan valid for 60 mos.* ☐ **AUTHORIZATION TO CONSTRUCT** *valid for period equal to IMPROVEMENT PERMIT, not to exceed 60 mo.*

Owner / Applicant Signature: Stephen A Ku Date: 9-1-16 Installed by: Abey Lyons

IMPROVEMENT PERMIT by: Date: 8/30/16 OPERATION PERMIT by: W Sparks Date: 9/12/16

AUTHORIZATION TO CONSTRUCT by: Maria Dotson RS Date: 9/1/16 Existing System Inspected by: Date:

Health Dept. Copy - WHITE Applicant (Final Approval) - YELLOW Applicant (Conditional Approval) - PINK


1" = 40'
Brown Farms Childers
DB 2412 pg 2049
N 84°50'15"W 74.12'
N 84°50'15"W 68.63'
N 84°50'15"W 65.98'
ER
12
Lot 13
NORTH
PB 33 pg 77
Dec 1998
35' Rear Setback
1 P 74'
2 Y 71'
3 O 111'
4 B 105'
5 R 116'
6 P 98'
7 Y 72'
8 O 42'
Lot 14
Brown Farms Childers
DB 2412 pg 2049
APPROVED AUG 3 1 2016
S 14°31'18"W 302.27'
15' Side Setback
Lot 15
0.599 Acre
15' Side Setback
N 07°12'36"E 308.78'
Lot 16
Lisa Flowers
DB 1961 pg 612
10'
IST
19.20'
56'
19.56'
28'
Proposed Dwelling
DRIVEWAY
35' Front Setback
WELL
49.8'
PROPOSED WELL
WELL
S 79°09'57"E 104.62'
A=104.69' R=817.87'
Brown Farms Drive 50' R/W