IREDELL COUNTY HEALTH DEPARTMENT

STATESVILLE 704-878-5305 MOORESVILLE 704-664-5281

IMPROVEMENT PERMIT / AUTHORIZATION TO CONSTRUCT / OPERATION PERMIT / EXISTING SYSTEM INSPECTION

PERMIT# 83206 PIN# 4773501149 DATE 8-19-99

OWNER OR CONTRACTOR Danna Lackey PHONE: Business 704 924 7424 Home

ADDRESS 171 Dogwood Est. / Statesville

LOCATION 70E TR Triplett Rd TR Brown Farms Drive 4th lot Rt.

SUBDIVISION JR Brown Farms BLOCK / SECTION 2 LOT 9 LOT AREA .75 SITE CLASS PS DESIGN FLOW 360 L.T.A.R. .33

Septic Tank: 1000 Gallons; STB 1012 Date 7-2599

Pump Tank: 1000 Gallons; PT 19 Date

Pump Make: HydroMatic Model SHEF50A1 Serial No.

Nitrification Field: No Fields 1 Square Feet 1080 Linear Feet 360

No Lines 5 Trench Width 36" Max Trench Bottom Depth 36" Gravel Depth 12"

(✓) New System ( ) Repair System Type: I, II, III, IV, V, VI

System Description: Pump To Conv.

Repair System Description: 25% Red.

Maintenance Agreement Required: ( ) Yes (✓) No

( ) House/Mod. Home No. Bedrooms 3

(✓) Mobile Home No. Bathrooms 2

( ) Business No. Employees

( ) Other


( ) Slab (✓) Crawl Space ( ) Basement w/plumbing ( ) Basement wo/plumbing

Water Supply: (✓) Individual ( ) Public ( ) Community


Comments/Conditions: See Attached sheets for Pump Tank + Pressure manifold set up.

Comments/Conditions 10-7 Top # Line inspected by Steve + Tim R/Rep
10-8: 5th Line inspected And pressure set Lines + Tanks Installed As Shown

INITIAL SITE SKETCH

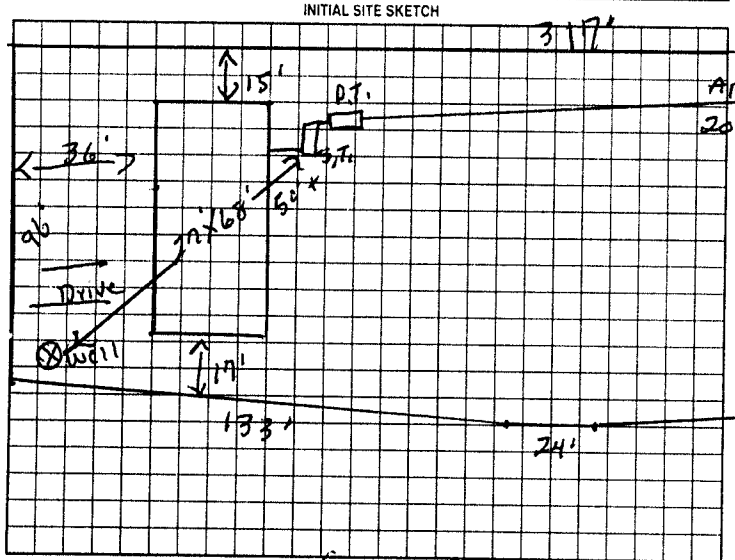

AS BUILT SKETCH

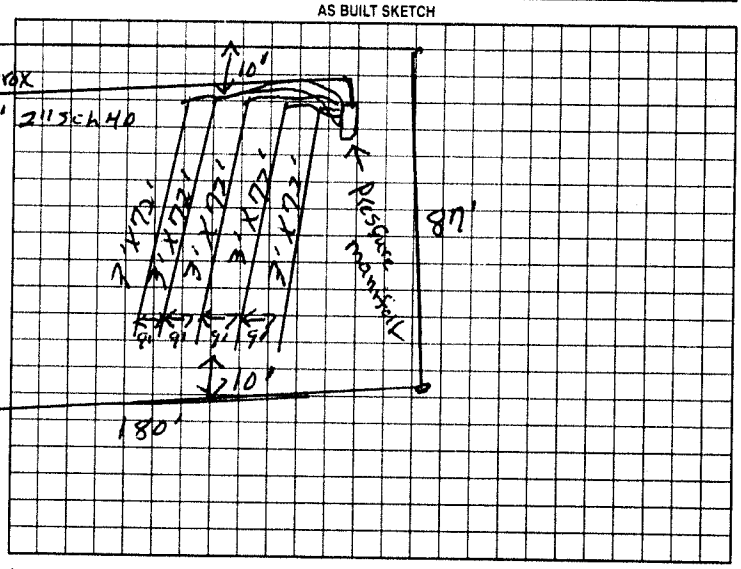

Street

Permit can be suspended or revoked if any false information is supplied toward securing the permit/any unauthorized changes are made to the site/any unauthorized changes are made in the installation of the system. Improvement Permit with plat valid without expiration. Improvement Permit with site plan valid for sixty months. Authorization to Construct is valid for a period equal to that of Improvement Permit - not to exceed sixty months.

Signed: Joey Tallent date Installed by: CRAIG Thompson Grading

Improvement Permit by: R. C. Moore date 8-19-99 Operation Permit by: R. C. Moore date 12-15-99

Authorization to Construct by: R. C. Moore date 8-19-99 Existing System Inspection by: date

HEALTH DEPT COPY: WHITE OWNER COPY (FINAL): YELLOW OWNER COPY (INITIAL): PINK