IREDELL COUNTY HEALTH DEPARTMENT

Statesville Office (704) 878-5305 Mooresville Office (704) 660-3625 PERMIT # 213033

IMPROVEMENT PERMIT / AUTHORIZATION TO CONSTRUCT / OPERATION PERMIT / EXISTING SYSTEM

PIN # 4773506348

APPLICANT: Eric Ward / Freedom Homes APPLICANT ADDRESS: 1124 Charlotte Hwy

SITE ADDRESS: 116 JD Ln Cleveland NC 27013 PHONE: 704-883-6148 ALT. PHONE: 704-929-9503


SITE DIRECTIONS: 21 to Oswalt Amity T/L Triplett Rd T/L JD Ln lot 2nd on right

SUBDIVISION: N/A SECTION: N/A LOT # N/A LOT AREA: 1 ac DESIGN FLOW: 360 L.T.A.R.: 0.25

Septic Tank	1000	(gal)	STB	760	Date	5-30-15	[X] New System	[ ] Repair	[ ] Expansion	System Type: I II III IV V VI	[X] Residence	No. Bedrooms	3	Water Supply	
Pump Tank	N/A	(gal)	PT	N/A	Date	N/A	System Description:			25% Reduction	[ ] Business	No. Persons	6	[X] Private	
Pump Make	N/A	Model	Polylok		Serial #	PL-68	Repair System Description:			50% Reduction	[ ] Other	No. Employees		[ ] Public	
# Nitrification Fields	1	# Lines	3		Linear Ft:	360	Maintenance Agreement Required:		[ ] YES	[X] NO	[ ] Slab	[X] Crawl Space		[ ] Community	
Trench Width	36"	Max. Trench Bottom Depth	36"		Gravel Depth	N/A	[X] GRAVITY		[ ] PRESSURE		[ ] Basement w/plumbing			[ ] Basement w/o plumbing	

Comments / Conditions: Install 25% reduction on contour with serial distribution. Maintain 36" trench depth on high side.

INITIAL SITE SKETCH

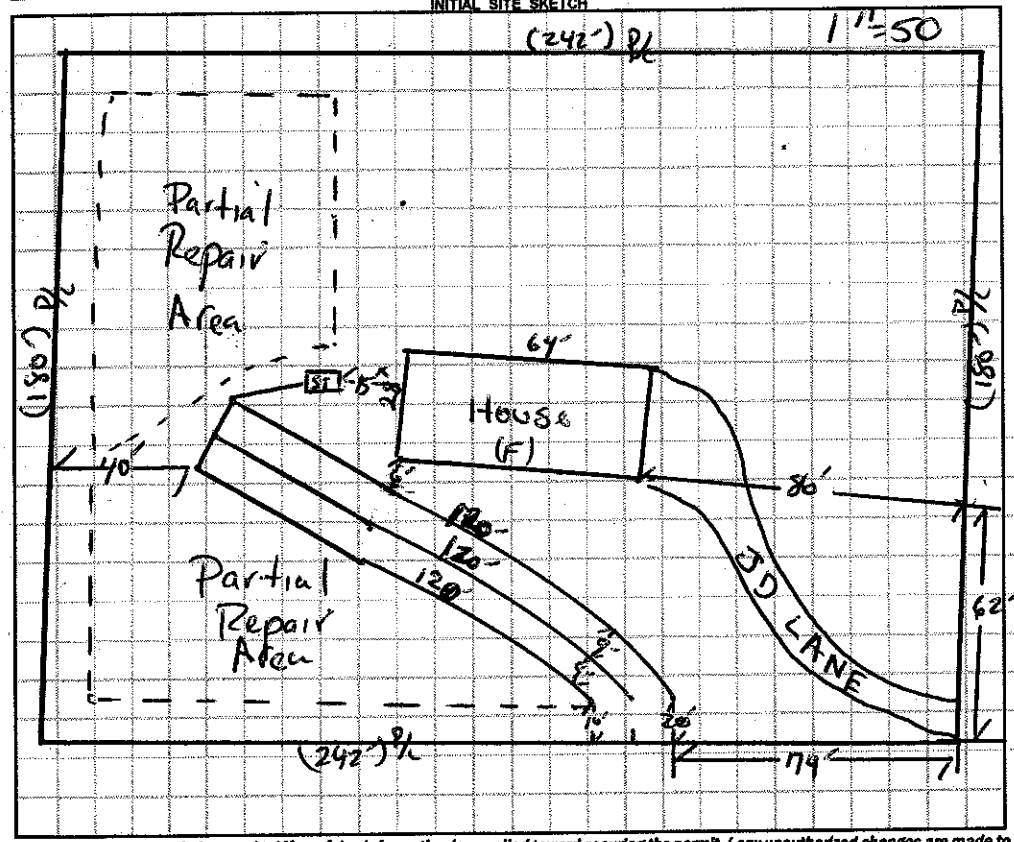

AS BUILT SKETCH

Installed Arc 36 as drawn No home at time of installation

Permit can be suspended or revoked if any false information is supplied toward securing the permit / any unauthorized changes are made to the site / any unauthorized changes are made in the installation of the system. **CONTACT A LOCATOR SERVICE PRIOR TO ANY EXCAVATION**

[ ] **IMPROVEMENT PERMIT** *with plat valid without expiration.* [X] **IMPROVEMENT PERMIT** *with site plan valid for 60 mos.* [X] **AUTHORIZATION TO CONSTRUCT** *valid for period equal to IMPROVEMENT PERMIT--not to exceed 60 mo.*

Owner / Applicant Signature: Eric Ward Date: 10-1-15 Installed by: Abels Gradney

IMPROVEMENT PERMIT by: David H Lee Date: 09/22/15 OPERATION PERMIT by: David H Lee Date: 10/06/15

AUTHORIZATION TO CONSTRUCT by: David H Lee Date: 09/22/15 Existing System Inspected by: Date:

Health Dept. Copy - WHITE Applicant (Final Approval) - YELLOW Applicant (Conditional Approval) - PINK