4:00

IREDELL COUNTY HEALTH DEPARTMENT

STATESVILLE 704-878-5305 CI MOORESVILLE 704-664-5281

IMPROVEMENT PERMIT / AUTHORIZATION TO CONSTRUCT / OPERATION PERMIT / EXISTING SYSTEM INSPECTION

PERMIT# 134768 PIN# 4773533613 DATE 5-2-06

OWNER OR APPLICANT Burchette Construction PHONE: Business 704 202 2003 Home 704 209 0984

ADDRESS 3000 Salisbury Hwy

LOCATION Hwy 70 toward Rowan County Line, just before Triplet Rd. on (R)

SUBDIVISION n/a BLOCK / SECTION n/a LOT n/a LOT AREA SITE CLASS. PS DESIGN FLOW 360 L.T.A.R. .2

Septic Tank: 1000 Gallons; STB 826 Date 5-20-06
Pump Tank: Gallons; PT Date
Pump Make: Model Serial No.
Nitrification Field: No Fields 1 Square Feet 1800 Linear Feet 450
No Lines 6 Trench Width 36" Max Trench Bottom Depth 36"

☒ New System ☐ Repair ☐ Expansion System Type: I II III IV V VI
System Description: 25% Reduction - Gravity
Repair System Description: 50% Reduction - Pump
Maintenance Agreement Required: ☐ Yes ☐ No

☒ House/Mod. Home No. Bedrooms 3
☐ Mobile Home No. Persons
☐ Business No. Employees
☐ Other


Water Supply: ☒ Individual ☐ Public ☐ Community

Gravel Depth n/a ☒ Gravity ☐ Pressure ☐ Slab ☐ Crawl Space ☐ Basement w/plumbing ☒ Basement wo/plumbing


Comments:/Conditions:

Comments:/Conditions:
Blue Ribbon
no risers
no S/T marks

INITIAL SITE SKETCH

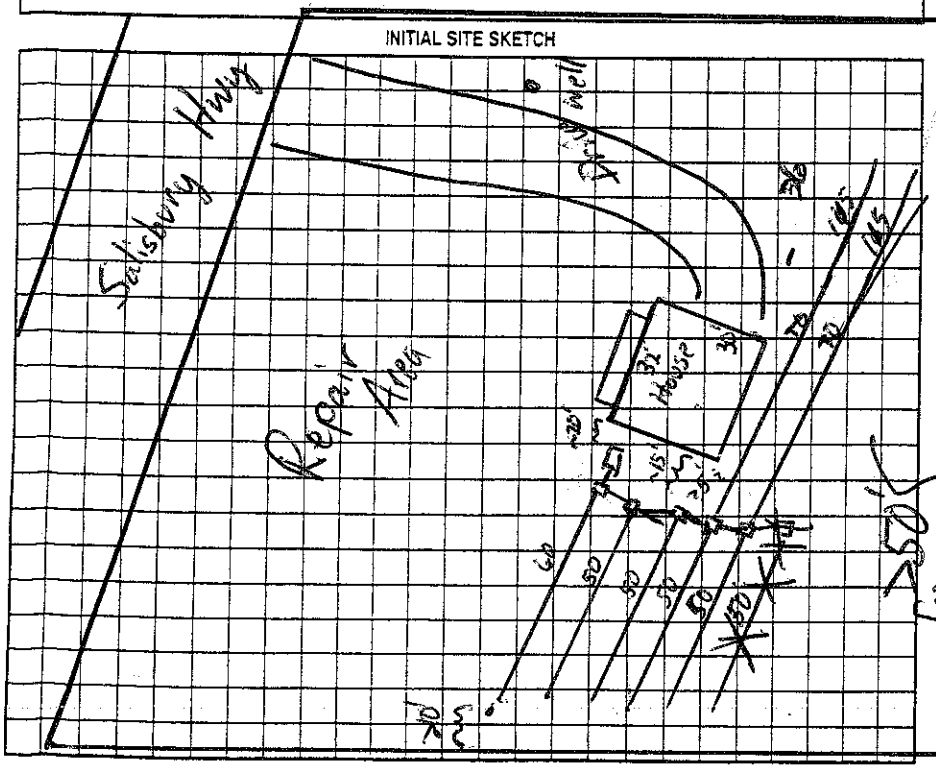

AS BUILT SKETCH

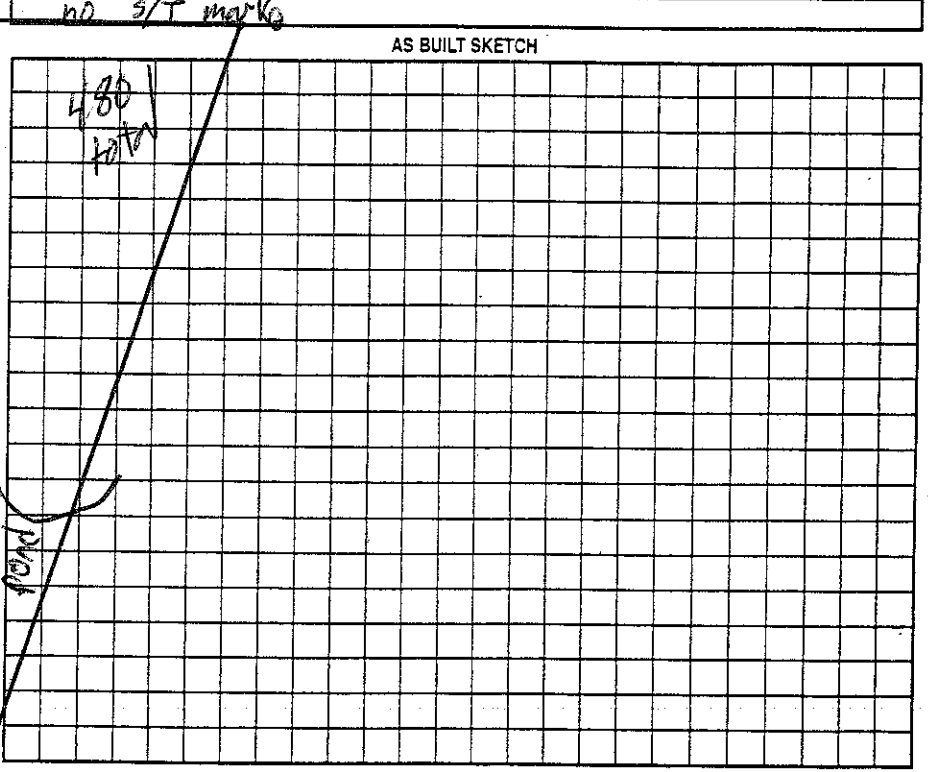

Permit can be suspended or revoked if any false information is supplied toward securing the permit/any unauthorized changes are made to the site/any unauthorized changes are made in the installation of the system. Improvement Permit with plat valid without expiration ☐ Improvement Permit with site plan valid for sixty months ☐ Authorization to Construct is valid for a period equal to that of Improvement Permit – not to exceed sixty months.

Signed Timothy L Burchette date 5-8-06 Installed by: Ronnie Dye Backhoe

Improvement Permit by: James Allen date 5-2-06 Operation Permit by: James Allen date 9-19-06

Authorization to Construct by: James Allen date 5-2-06 Existing System Inspection by: date

HEALTH DEPT. COPY: WHITE OWNER COPY (FINAL): YELLOW OWNER COPY (INITIAL): PINK