IREDELL COUNTY HEALTH DEPARTMENT

Statesville Phone TR 3-7271 Mooresville Phone NO 3-1271

PERMIT TO INSTALL SEPTIC TANK

Permit NO. Materials Lumber Co. Permit Date 3 - 1 - 1961

Owner Raford Warren Address @ Elmwood N.C.

Installed By CLYDE HOKE Address R 7


Location of Property right on Pave before Courthouse See - Past 2 stop back left. 2nd on left

Tank		Capacity		Length of Lines		Fixtures	
Block	( )	800	( )	150'	( )	No. of Baths	( )
Precast	(—)	900	( )	175'	( )	Dishwasher	( )
		1000	( )	200'	( )	Garbage Grdr.	( )
		1100	( )	225'	(—)	Auto-Washer	( )
		1200	( )	250'	( )	Other	
		Other		Other			

NOTIFY HEALTH DEPARTMENT AT LEAST EIGHT HOURS BEFORE TANK IS TO BE INSPECTED.

Final Inspection 3 - 1 - 1961 Approved (—) Disapproved ( )

Remarks Not responsible for damage due to frozen pipes well 50' [illegible] self cups.

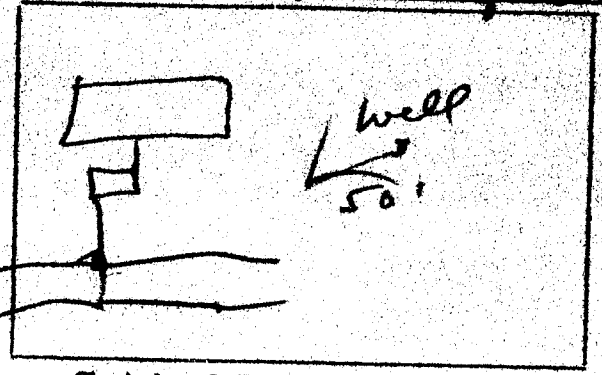

Sketch of Installation

P.H.

Sanitarian