903 - 8010 WES LYTTON

IREDELL COUNTY HEALTH DEPARTMENT

STATESVILLE 704-878-5305 MOORESVILLE 704-664-5281

IMPROVEMENT PERMIT / AUTHORIZATION TO CONSTRUCT / OPERATION PERMIT / EXISTING SYSTEM INSPECTION

PERMIT# Repair PIN# 4773 53 9037 (621919 DATE 6-14-06

OWNER OR APPLICANT Jerry C Brown PHONE: Business Home 704-872-7573

ADDRESS 3044 Salisbury Hwy Statesville, NC 28677

LOCATION 70 East @ B4 Triplett Rd At Box # 3044

SUBDIVISION BLOCK / SECTION LOT LOT AREA 1.67AC SITE CLASS. B DESIGN FLOW — L.T.A.R. —

Septic Tank: Existing Gallons; STB Date

Pump Tank: Gallons; PT Date

Pump Make: Model Serial No.

Nitrification Field: No Fields 1 Square Feet — Linear Feet 240'

No Lines 3x80' Trench Width 36" Max Trench Bottom Depth 18" Gravel Depth 12" ☒ Gravity ☐ Pressure

☐ New System ☒ Repair ☐ Expansion System Type: I II III IV V VI

System Description: Conv Gravity

Repair System Description:

Maintenance Agreement Required: ☐ Yes ☒ No

☒ House/Mod. Home ☐ Mobile Home ☐ Business ☐ Other

No. Bedrooms — No. Persons 2 No. Employees —


Water Supply: ☒ Individual ☐ Public ☐ Community

☐ Slab ☐ Crawl Space ☐ Basement w/plumbing ☒ Basement wo/plumbing


Comments/Conditions: (1) THIS REPORT SERVES AS NOTICE OF VIOLATION & MUST BE ADDRESSED WITHIN 30 DAYS; (2) NOTE MAXIMUM TRENCH BOTTOM DEPT IF NOT TO SCALE"

Comments/Conditions: (3) MEET LOWER CODE AS, BEFORE INSTALLATION; (INSTALLER) must (4) CHECK TEE IN TANK & REPLACE IF NECESSARY

INITIAL SITE SKETCH

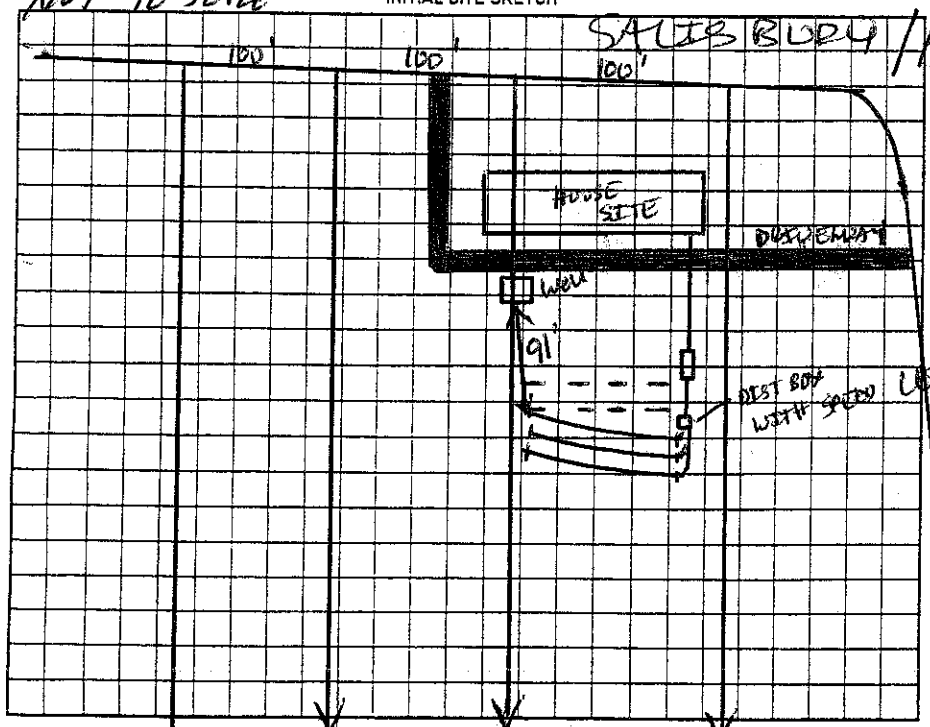

AS BUILT SKETCH

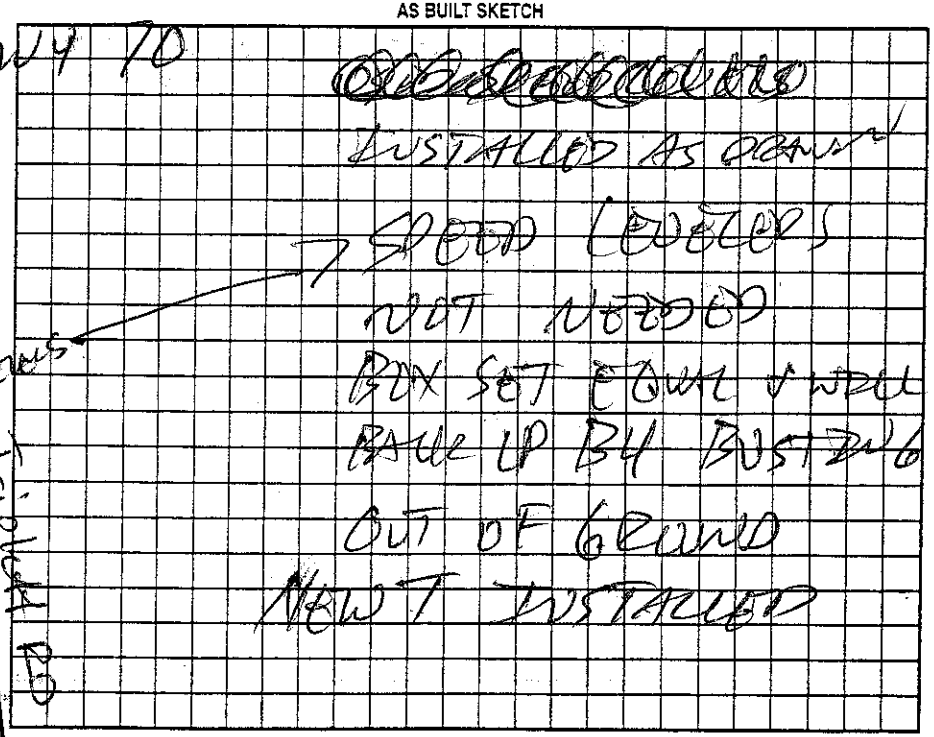

Permit can be suspended or revoked if any false information is supplied toward securing the permit/any unauthorized changes are made to the site/any unauthorized changes are made in the installation of the system. Improvement Permit with plat valid without expiration ☐ Improvement Permit with site plan valid for sixty months ☒ Authorization to Construct is valid for a period equal to that of Improvement Permit – not to exceed sixty months.

Signed: Jerry C Brown date 6-5-06

Improvement Permit by: [signature] date 6-14-06

Authorization to Construct by: [signature] date 6-14-06

Installed by: Wes Lytton

Operation Permit by: [signature] date 6-22-06

Existing System Inspection by: date

HEALTH DEPT. COPY: WHITE OWNER COPY (FINAL): YELLOW OWNER COPY (INITIAL): PINK