IREDELL COUNTY HEALTH DEPARTMENT

STATESVILLE 704-878-5305 MOORESVILLE 704-664-5281

IMPROVEMENT PERMIT / AUTHORIZATION TO CONSTRUCT / OPERATION PERMIT / EXISTING SYSTEM INSPECTION

PERMIT# 74698 PIN# 4773 73 9057 DATE 6-24-98

OWNER OR CONTRACTOR Hope Brothers PHONE: Business 872 Hill Home

ADDRESS 1120 Barkley Rd Sta.

LOCATION 123 Thompson Ln NOE TL Elmwood RT cross RR TR Thompson at end

SUBDIVISION BLOCK / SECTION LOT LOT AREA .85acres SITE CLASS PS DESIGN FLOW 360 L.T.A.R. .2

Septic Tank: 1000 Gallons; STB 1012 Date 5-12-98
Pump Tank: Gallons; PT Date
Pump Make: Model Serial No.
Nitrification Field: No Fields 1 Square Feet 1350 Linear Feet 450
No Lines 4 Trench Width 36" Max Trench Bottom Depth 24" Gravel Depth N/A

☑ New System ☐ Repair System Type: I, II, III, IV, V, VI
System Description: 25% Reduction System
Repair System Description: " " "
Maintenance Agreement Required: ☐ Yes ☑ No

☐ House/Mod. Home No. Bedrooms 3
☑ Mobile Home No. Bathrooms 2
☐ Business No. Employees
☐ Other


☐ Slab ☐ Crawl Space ☐ Basement w/plumbing ☐ Basement wo/plumbing

Water Supply: ☑ Individual ☐ Public ☐ Community


Comments:/Conditions:

Comments:/Conditions: Same as initial Sketch

INITIAL SITE SKETCH

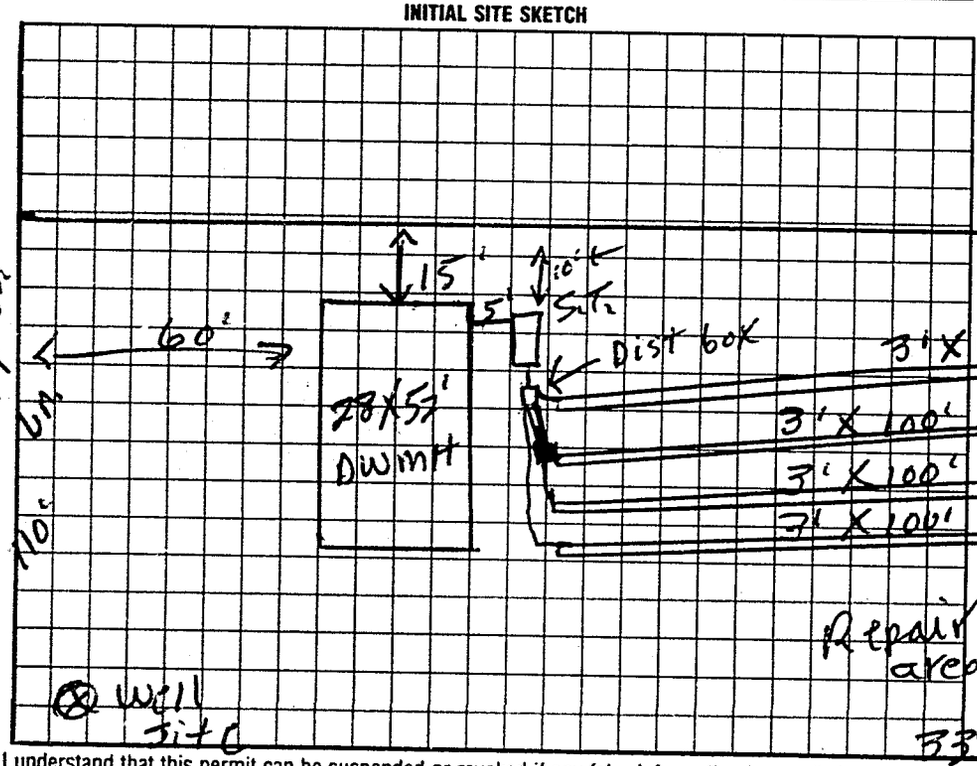

AS BUILT SKETCH

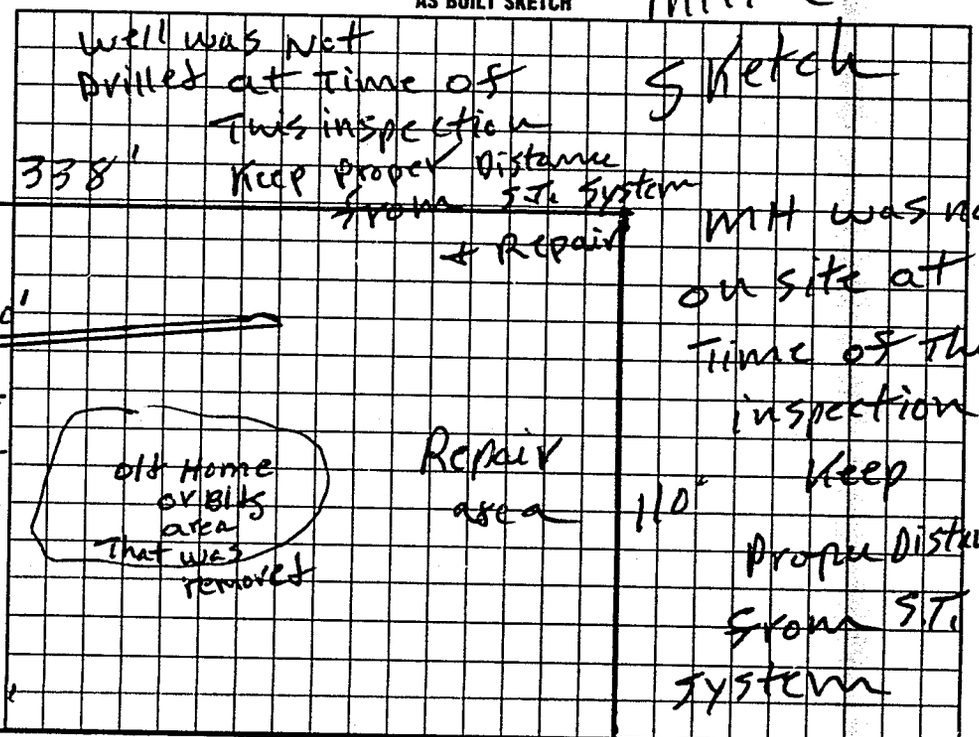

I understand that this permit can be suspended or revoked if any false information is supplied toward securing the permit/any unauthorized changes are made to the site/any unauthorized changes are made in the installation of the system. Improvement Permit with plat valid without expiration. Improvement Permit with site plan valid for sixty months. Authorization to Construct is valid for a period equal to that of Improvement Permit – not to exceed sixty months.

Signed: date 7-9-98 Installed by: Arnie Duncan

Improvement Permit by: R. C. Moore date 6-24-98 Operation Permit by: R. C. Moore date 7-23-98

Authorization to Construct by: R. C. Moore date 6-24-98 Existing System Inspection by: date

HEALTH DEPT COPY: WHITE INSPECTION COPY (FINAL): GREEN OWNER COPY (FINAL): YELLOW INSPECTION COPY (INITIAL): PINK OWNER COPY (INITIAL): GOLD