IREDELL COUNTY HEALTH DEPARTMENT

STATESVILLE 704-878-5305 MOORESVILLE 704-664-5281

IMPROVEMENT PERMIT / CERTIFICATE OF COMPLETION / OPERATION PERMIT / EXISTING SYSTEM INSPECTION

PROPERTY DESCRIPTION NO. 16274 DATE 6-1-93 TAX MAP NO. 3Q-5-A-12

OWNER OR CONTRACTOR Debra Bost PHONE: Business 873-5779 Home

ADDRESS

LOCATION I40W TL Old Mtn. Rd TR Buffalo Shoals TR Eufola Rd. TR Low Lane Rd. 2nd & 3rd Lot on R.

SUBDIVISION Wade S. Lambeth BLOCK / SECTION LOT 12 LOT AREA 1.153 acre SITE CLASS. PS. L.T.A.R. .35 gpd/ft²

Water Supply: ☑ Individual ☐ Community ☐ Public Well To Be Located.

Septic Tank: 1000 Gallons; STB 1012 Date 4-19-93

Pump Tank: — Gallons; PT — Date —

Nitrification Field: No Fields 1 Square Feet 1035 Linear Feet 345'

No Lines 5 Trench Width 36" Trench Depth 24"-30" Gravel Depth 12"

☑ New System ☐ Repair System Type: I. II (III) IV. V. VI

System Description: Conventional, gravity fed

Repair System Description:

Maintenance Agreement Required: ☐ Yes ☑ No

☐ House/Mod. Home ☑ Mobile Home ☐ Business ☐ Other

No. Bedrooms 3 No. Bathrooms 2 No. Employees —

☐ Slab ☑ Crawl Space ☐ Basement w/plumbing ☐ Basement wo/plumbing

Garbage Disposal: ☐ Yes ☑ No

Auto. Dishwasher: ☑ Yes ☐ No


Auto. Washing Machine: ☑ Yes ☐ No

Other

Comments Keep MH min 5' from any part of septic System. Keep well min. 50' from any part of septic system and 50' from Repair Area.

INITIAL SITE SKETCH

AS BUILT SKETCH

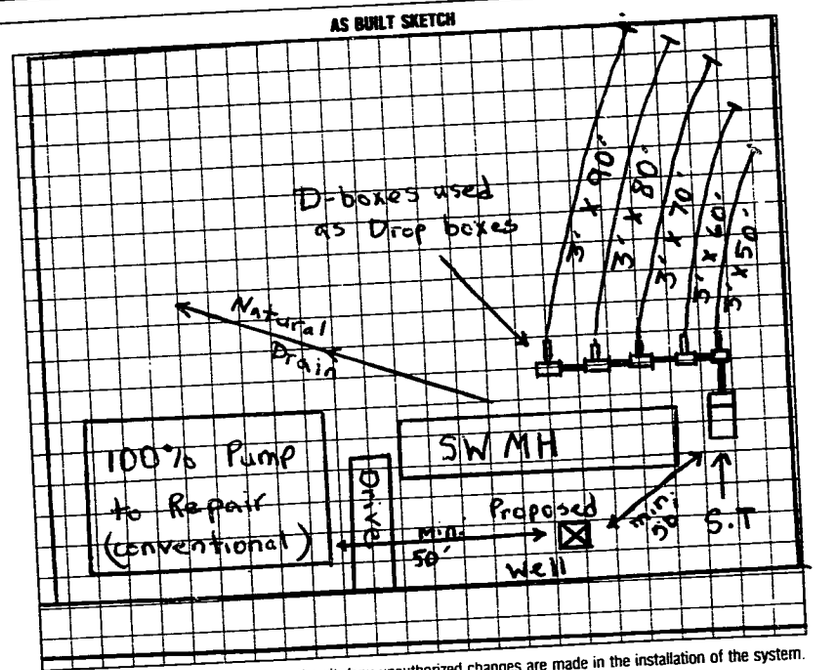

I understand that this permit can be suspended or revoked if any false information is supplied toward securing the permit/any unauthorized changes are made to the site/any unauthorized changes are made in the installation of the system. Improvement Permit is valid for 60 months from date of issuance.

Signed:

Improvement Permit by: Michael J. Dennis date 5-5-93

Existing System Inspection by: date

Installed by: Harry Reep date 6-1-93

Certificate of Completion by: Michael J. Dennis date

Operation Permit by: date

HEALTH DEPT. COPY: WHITE INSPECTION COPY (FINAL): GREEN OWNER COPY (FINAL): YELLOW INSPECTION COPY (INITIAL): PINK OWNER COPY (INITIAL): GOLD