IREDELL COUNTY HEALTH DEPARTMENT - *ENVIRONMENTAL HEALTH* ☑ STATESVILLE OFFICE 704-878-5305 ☐ MOORESVILLE OFFICE 704-664-5281

IMPROVEMENT PERMIT / AUTHORIZATION TO CONSTRUCT / OPERATION PERMIT / EXISTING SYSTEM INSPECTION

PERMIT # Repair PIN # 4773-82-6989 DATE 9 7-7-11

OWNER Diane Sutton APPLICANT: PHONE: Home/Cell # 704-872-4234 Business #

SITE ADDRESS 117 Roundabout OWNER / APPLICANT ADDRESS 117 Roundabout

SITE DIRECTIONS 775, 70E, then Old Hwy 70. Roundabout on left.

SUBDIVISION n/a BLOCK / SECTION n/a LOT # n/a LOT AREA 3 Ac. DESIGN FLOW 240 L.T.A.R. 3

Septic Tank Existing Gallons: STB Date

Pump Tank Gallons: P T Date

Pump Make Model Serial #

No. Nitrification Fields: 1 No. Lines 3 Linear Feet 267 total

Trench Width 36" Max. Trench Bottom Depth 36" Gravel Depth 12"

☐ New System ☒ Repair ☐ Expansion System Type I (II) III IV V VI

System Description: 2 Conventional Gravity

Repair System Description:

Maintenance Agreement Required ☐ YES ☒ NO

☒ GRAVITY ☐ PRESSURE

☒ Residence No. Bedrooms 2

☐ Business No. Persons

☐ Other No. Employees

☐ Slab ☒ Crawl Space


☐ Basement w/plumbing ☐ Basement w/o plumbing

Water Supply: ☒ Private ☐ Public ☐ Community

Comments / Conditions: An accepted system may also be used

new 1000 gal tank may be installed if necessary

INITIAL SITE SKETCH

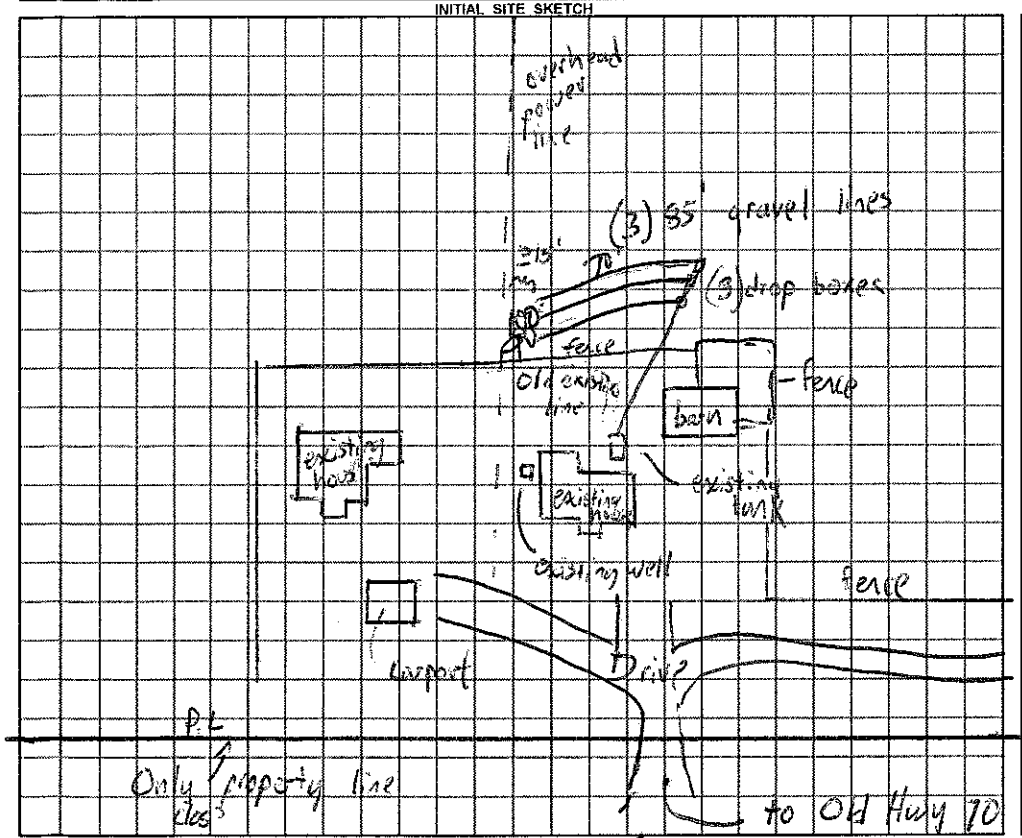

AS BUILT SKETCH

Installed as Drawn

using Distribution box

instead of 3 drop-boxes.

Permit can be suspended or revoked if any false information is supplied toward securing the permit / any unauthorized changes are made to the site / any unauthorized changes are made in the installation of the system.

☐ ***IMPROVEMENT PERMIT*** with plat valid without expiration. ☑ ***IMPROVEMENT PERMIT*** with ~~plat valid without expiration.~~ site plan valid 60 mo. ☑ ***AUTHORIZATION TO CONSTRUCT*** valid for period equal to IMPROVEMENT PERMIT--not to exceed 60 mo.

Owner / Applicant Signature: Diane L Sutton Date 7-8-11 Installed by: A.J. Buckhur

IMPROVEMENT PERMIT by: REHS Date 7-7-11 OPERATION PERMIT by: REHS Date 9 Aug 11

AUTHORIZATION TO CONSTRUCT by: REHS Date 7-7-11 Existing System Inspected by: REHS Date

YOU SHOULD CONTACT A LOCATOR SERVICE PRIOR TO ANY EXCAVATION

White Copy – Environmental Health YELLOW COPY (Final) Owner / Applicant PINK COPY (Initial) Owner / Applicant