REDELL COUNTY HEALTH DEPARTMENT

STATESVILLE 704-878-5305 MOORESVILLE 704-664-5281

IMPROVEMENT PERMIT / CERTIFICATE OF COMPLETION / OPERATION PERMIT / EXISTING SYSTEM INSPECTION

OPERTY DESCRIPTION NO. 67227 DATE 6-26-97 TAX MAP NO. 4773913574 Watershed: ☐ Yes ☑ No

WNER OR CONTRACTOR Susan Weaver PHONE: Business Home 704 483 6826

DRESS 1503 Triangle circle Denver, N.C. 28037

CATION No E past S Knox Fm Rd 1000' on Rt.

BDIVISION BLOCK / SECTION LOT LOT AREA 32acres SITE CLASS PS DESIGN FLOW 360 L.T.A.R. .2

eptic Tank: 1000 Gallons; STB 1012 Date 5-12-97

ump Tank: 1000 Gallons; PT 17 Date 10-20-96

ump Make: Hydromatic Model Sheff 100M2 Serial No. 13425-037-1

trification Field: No Fields 1 Square Feet 1800 Linear Feet 600

o Lines 8 Trench Width 36" Max Trench Bottom Depth 24" Gravel Depth 12"

☑ New System ☐ Repair System Type: I, II, (III) IV, V, VI

System Description: Pump to Conv.

Repair System Description: " " "

Maintenance Agreement Required: ☐ Yes ☑ No

☑ House/Mod. Home No. Bedrooms 3

☐ Mobile Home No. Bathrooms 2

☐ Business No. Employees

☐ Other

☐ Slab ☐ Crawl Space ☐ Basement w/plumbing ☐ Basement wo/plumbing


Water Supply: ☑ Individual ☐ Community ☐ Public

Comments:


See Attached Drawings for Pump Tank & Pressure manifold set up Also See detail on Drain line const. which are part of this permit.

Comments: Checked Drain Lines & S.T. P.T. 7-9-97 JCM

INITIAL SITE SKETCH

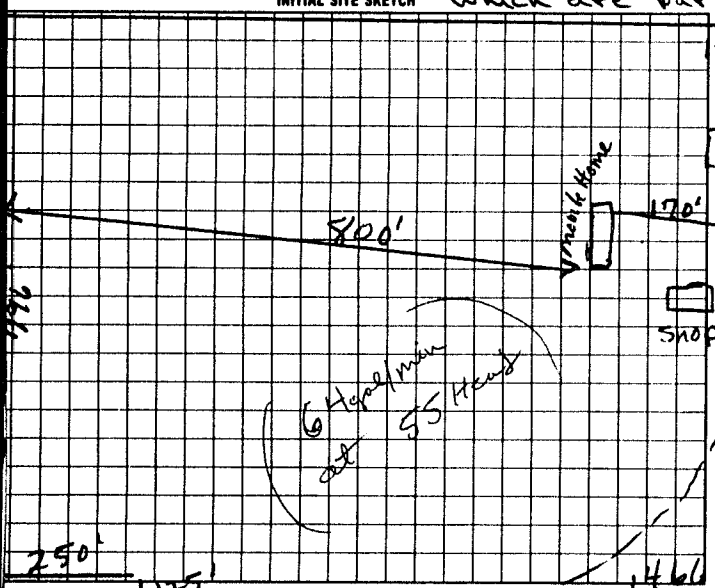

AS BUILT SKETCH

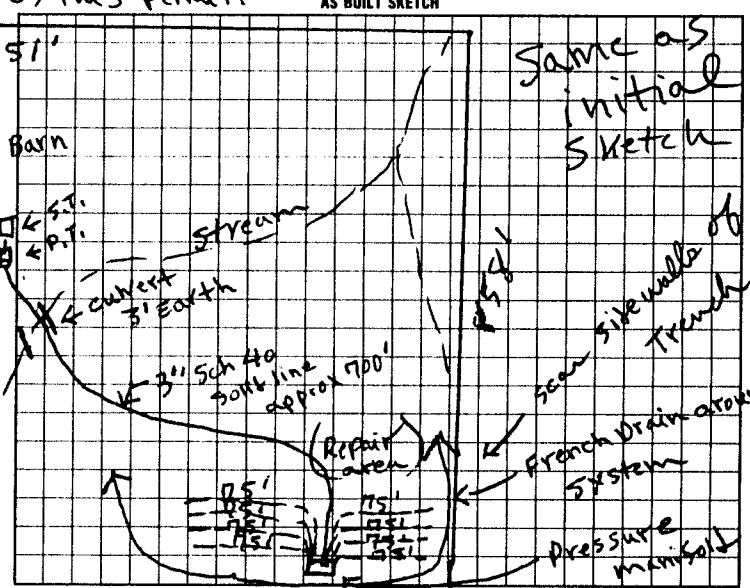

I understand that this permit can be suspended or revoked if any false information is supplied toward securing the permit/any unauthorized changes are made to the site/any unauthorized changes are made in the installation of the system. This Improvement Permit is valid for 60 months from date of issuance.

Signed: Susan Weaver Installed by: A-1 Backhoe

Improvement Permit by: P.C. Moore date 6-26-97 Certificate of Completion by: date

Authorization to Cover by: P.C. Moore date 6-26-97 Operation Permit by: P.C. Moore date 7-24-97

HEALTH DEPT. COPY: WHITE INSPECTION COPY (FINAL): GREEN OWNER COPY (FINAL): YELLOW INSPECTION COPY (INITIAL): PINK OWNER COPY (INITIAL): GOLD

Cover.

Authorization to Cover. Expires 60 mos from 6-26-97.