IREDELL COUNTY HEALTH DEPARTMENT

STATESVILLE 704-878-5305 MOORESVILLE 704-664-5281

IMPROVEMENT PERMIT / AUTHORIZATION TO CONSTRUCT / OPERATION PERMIT / EXISTING SYSTEM INSPECTION

PERMIT# 75209 PIN# 4773 96 3139 DATE 9-24-98

OWNER OR CONTRACTOR Jewel Valentine PHONE: Business Home 9748191

ADDRESS 3703 Brookwood Drive Charlotte N.C.

LOCATION TO E TO Elmwood Rd 1st Drive Past Elmwood Pres. Church

SUBDIVISION BLOCK / SECTION LOT LOT AREA 1.9 acre + 100'x138' Sewer Easement SITE CLASS PS DESIGN FLOW 360 L.T.A.R. 1.2

Septic Tank: 1000 Gallons; STB 1012 Date 9-5-98

Pump Tank: Gallons; PT Date

Pump Make Model Serial No

Nitrification Field: No Fields 1 Square Feet 1350 Linear Feet 450

No Lines 4 Trench Width 36" Max Trench Bottom Depth 24" Gravel Depth N/A

☒ New System ☐ Repair System Type: I, II, III, IV, V, VI

System Description: Gravity 25% Reduction

Repair System Description

Maintenance Agreement Required: ☐ Yes ☒ No

☒ House/Mod. Home No. Bedrooms 3

☐ Mobile Home No. Bathrooms 2

☐ Business No. Employees

☐ Other


☐ Slab ☐ Crawl Space ☐ Basement w/plumbing ☒ Basement wo/plumbing

Water Supply: ☒ Individual ☐ Public ☐ Community


Comments:/Conditions:

Comments:/Conditions: locate well at least 100' from Stream S.T. System of Repair

INITIAL SITE SKETCH

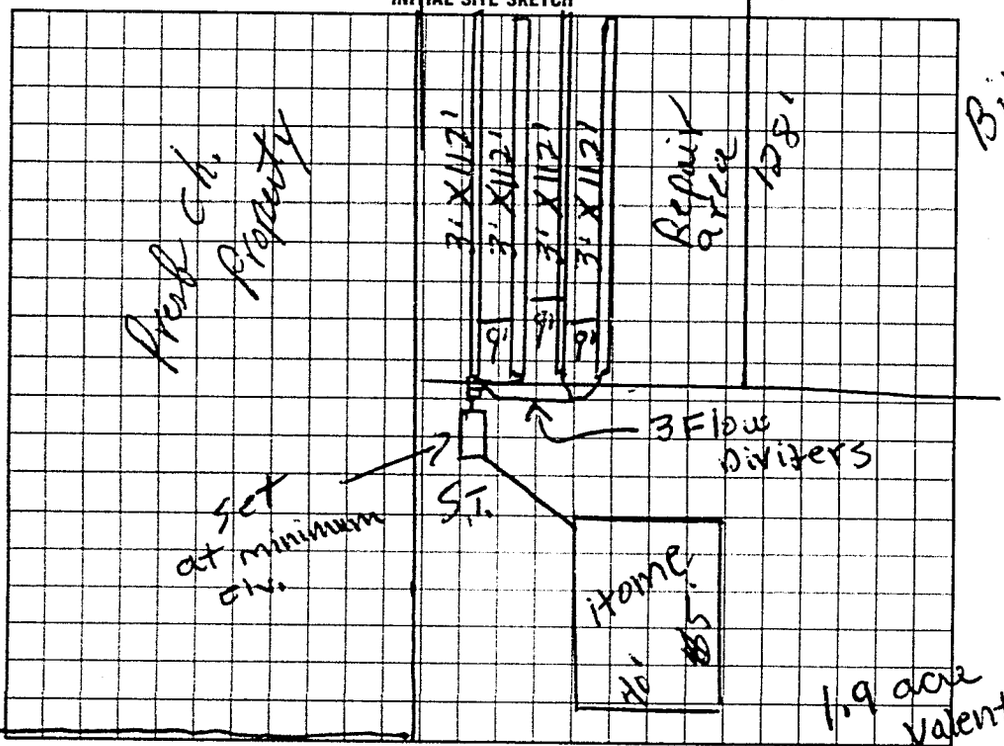

AS BUILT SKETCH

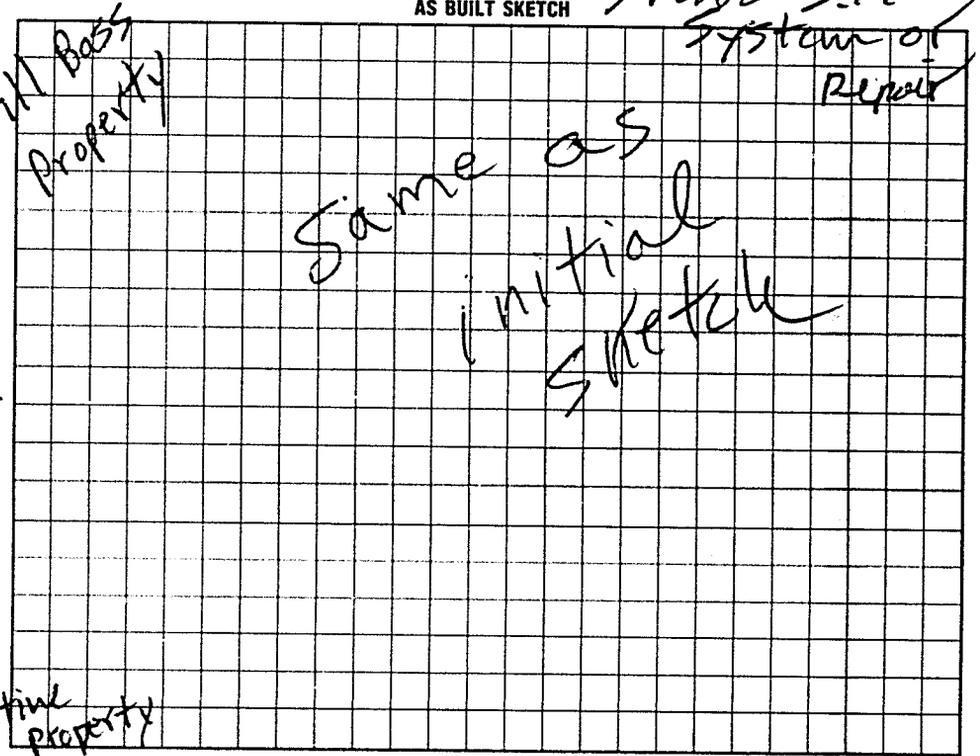

I understand that this permit can be suspended or revoked if any false information is supplied toward securing the permit/any unauthorized changes are made to the site/any unauthorized changes are made in the installation of the system. Improvement Permit with plat valid without expiration. Improvement Permit with site plan valid for sixty months. Authorization to Construct is valid for a period equal to that of Improvement Permit – not to exceed sixty months.

Signed: Jewel E Valentine date 9-29-98 Installed by: TOMMY ERVIN

Improvement Permit by: E. C. Moore date 9-24-98 Operation Permit by: E. C. Moore date 11-9-98

Authorization to Construct by: E. C. Moore date 9-24-98 Existing System Inspection by date

HEALTH DEPT COPY WHITE INSPECTION COPY (FINAL) GREEN OWNER COPY (FINAL) YELLOW INSPECTION COPY (INITIAL) PINK OWNER COPY (INITIAL) GOLD

28100