THIS PERMIT REPLACES EXPIRED PERMIT # 115899

IREDELL COUNTY HEALTH DEPARTMENT

STATESVILLE 704-878-5305 MOORESVILLE 704-664-5281

IMPROVEMENT PERMIT / AUTHORIZATION TO CONSTRUCT / OPERATION PERMIT / EXISTING SYSTEM INSPECTION

PERMIT# 142357 PIN# 4774-09-2556.001 DATE 5-23-2007

OWNER OR APPLICANT BILLY SCOTT PHONE: Business % 4774-09-2556 Home 828-310-1968

ADDRESS 5059 PEBBLE STONE MALDEN, NC 28650

LOCATION US 64 EAST, TR NEW SALEM ROAD, TR POTTERY DRIVE, 5TH TRACT ON RIGHT

SUBDIVISION STOVALL BLOCK / SECTION LOT 4 (2) LOT AREA ACREAGE SITE CLASS PS DESIGN FLOW 480 L.T.A.R. 0.25 GPD/FT2

Septic Tank: 1000 Gallons: STB 825 Date 5-29-07

Pump Tank: 1000 Gallons: PT 302 Date 5-14-07

Pump Make: Model eq. to 1720 Serial No.

Nitrification Field: No. Fields 1 Square Feet Linear Feet 480

No Lines FOUR Trench Width 36" Max Trench Bottom Depth 36"

☑ New System ☐ Repair ☐ Expansion System Type: I II III IV V VI

System Description: 25% REDUCTION PUMP

Repair System Description: 25% REDUCTION PUMP

Maintenance Agreement Required: ☐ Yes ☑ No

Gravel Depth N/A ☐ Gravity ☑ Pressure ☐ Slab ☑ Crawl Space ☐ Basement w/plumbing ☐ Basement wo/plumbing

☑ House/Mod. Home No. Bedrooms 4

☐ Mobile Home No. Persons

☐ Business No. Employees


☐ Other

Water Supply: ☑ Individual ☐ Public ☐ Community WELL


Comments/Conditions: ① INSTALL 25% REDUCTION SYSTEM ON CONTOUR ② SEE ATTACHED SHEETS FOR PUMP & PRESSURE MANIFOLD REQUIREMENTS.

Comments/Conditions:

INITIAL SITE SKETCH

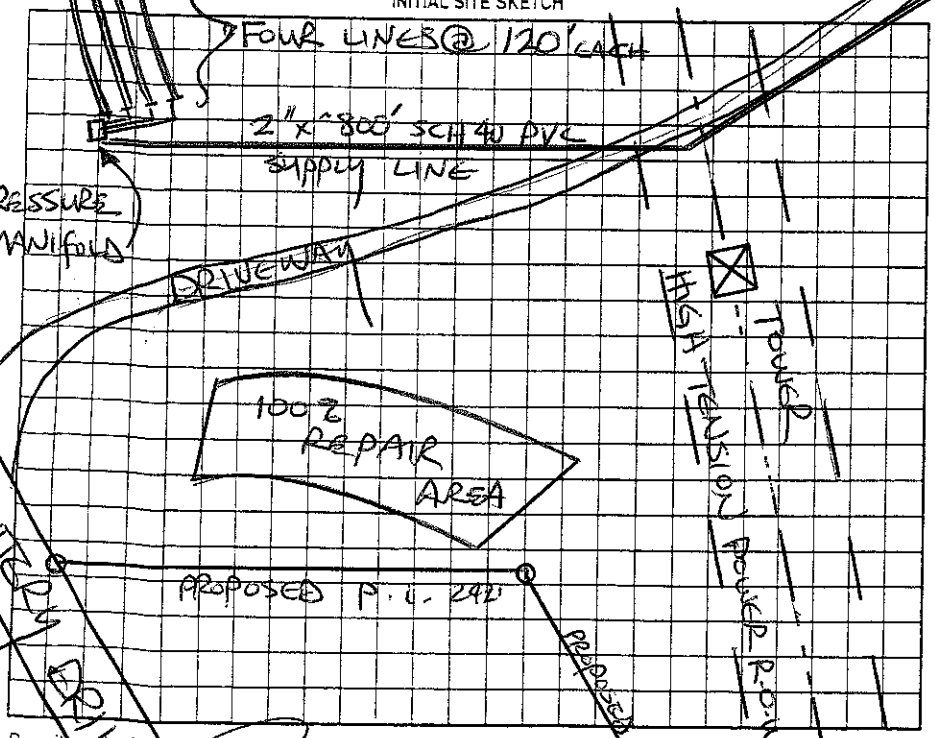

AS BUILT SKETCH

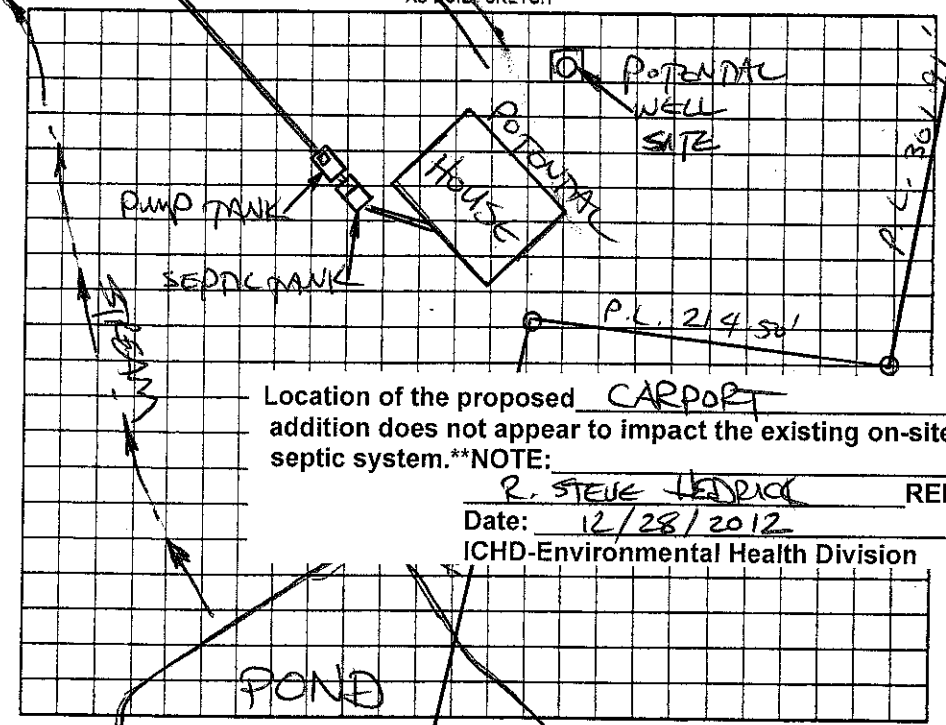

Location of the proposed CARPORT addition does not appear to impact the existing on-site septic system.**NOTE:

R. STEVE HEDRICK REHS

Date: 12/28/2012

ICHD-Environmental Health Division

Permit can be suspended or revoked if any false information is supplied toward securing the permit/any unauthorized changes are made to the site/any unauthorized changes are made in the installation of the system. Improvement Permit with plat valid without expiration ☐ Improvement Permit with site plan valid for sixty months ☑ Authorization to Construct is valid for a period equal to that of Improvement Permit – not to exceed sixty months.

Signed: date 5/25/07 Installed by: OPAL GRADING

Improvement Permit by: STEVE HEDRICK date 5-23-2007 Operation Permit by: R STEVE HEDRICK date 12/28/12

Authorization to Construct by: STEVE HEDRICK date 5-23-2007 Existing System Inspection by: date

HEALTH DEPT. COPY: WHITE OWNER COPY (FINAL): YELLOW OWNER COPY (INITIAL): PINK