IREDELL COUNTY HEALTH DEPARTMENT

STATESVILLE 704-878-5305 (E1) MOORESVILLE 704-664-5281

IMPROVEMENT PERMIT / AUTHORIZATION TO CONSTRUCT / OPERATION PERMIT / EXISTING SYSTEM INSPECTION

PERMIT# 110238 PIN# ~~4774-15-6790~~ 4774-16-8179 DATE 1-2-03

OWNER OR CONTRACTOR FRANCIS & SANDY BELL PHONE: Business 704-902-4014 Home 704-872-2155

ADDRESS 470 NEW SALEM RD STATESVILLE NC 28625

LOCATION 64 EAST ® NEW SALEM RD, ® J.J. LANE. BEHIND METAL SHOP ON LEFT

SUBDIVISION _____ BLOCK / SECTION _____ LOT _____ LOT AREA 4.36 AC SITE CLASS. PS DESIGN FLOW 360 L.T.A.R. .25

Septic Tank: 1000 Gallons; STB 1012 Date 3-3-03
Pump Tank: 1000 Gallons; P.T. 17 Date 1-26-03
Pump Make: GOULDS Model WE07121H Serial No. J0.353283
Nitrification Field: No Fields 1 Square Feet 1440' Linear Feet 500'
No Lines 5X100' Trench Width 36" Max Trench Bottom Depth 30" Gravel Depth 12"


☒ New System ☐ Repair System Type: I, II, (III), IV, V, VI
System Description: (E) PUMP (ONLY
Repair System Description: SAME
Maintenance Agreement Required: ☐ Yes ☒ No

☒ House/Mod. Home No. Bedrooms 3
☐ Mobile Home No. Bathrooms 2½
☐ Business No. Employees ____
☐ Other ____
☐ Slab ☐ Crawl Space ☒ Basement w/plumbing ☐ Basement wo/plumbing

Water Supply:
☒ Individual
☐ Public
☐ Community
EXISTING

Comments/Conditions: NEW SALEM ROAD ① OWNER WANTED A LITTLE MORE LINE LENGTH, MADE SYSTEM 5 LINES X 100' LONG. ② INSTALL LINES ON CONTOURS & KEEP

INITIAL SITE SKETCH "NOT TO SCALE"

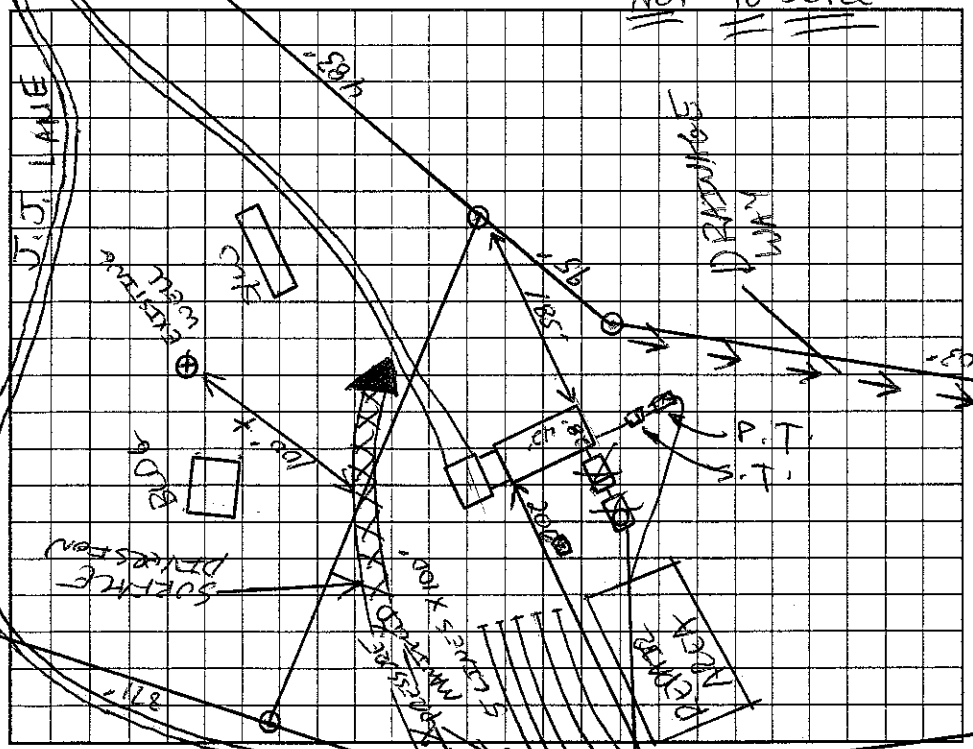


Comments/Conditions: TRENCH BOTTOM 30" DEEP OR SHALLOWER ③ MAINTAIN SETBACKS ④ IF NEW WELL IS DRILLED MAINTAIN A 100' SETBACK FROM SYSTEM & REPAIR. ⑤ CALL PRIOR TO INSTALLATION FOR PUMP INFO & SIZE

AS BUILT SKETCH

TANKS & LINES INSPECTED 9-19-03

SYSTEM INSTALLED ACCORDING TO INITAL SITE SKETCH.

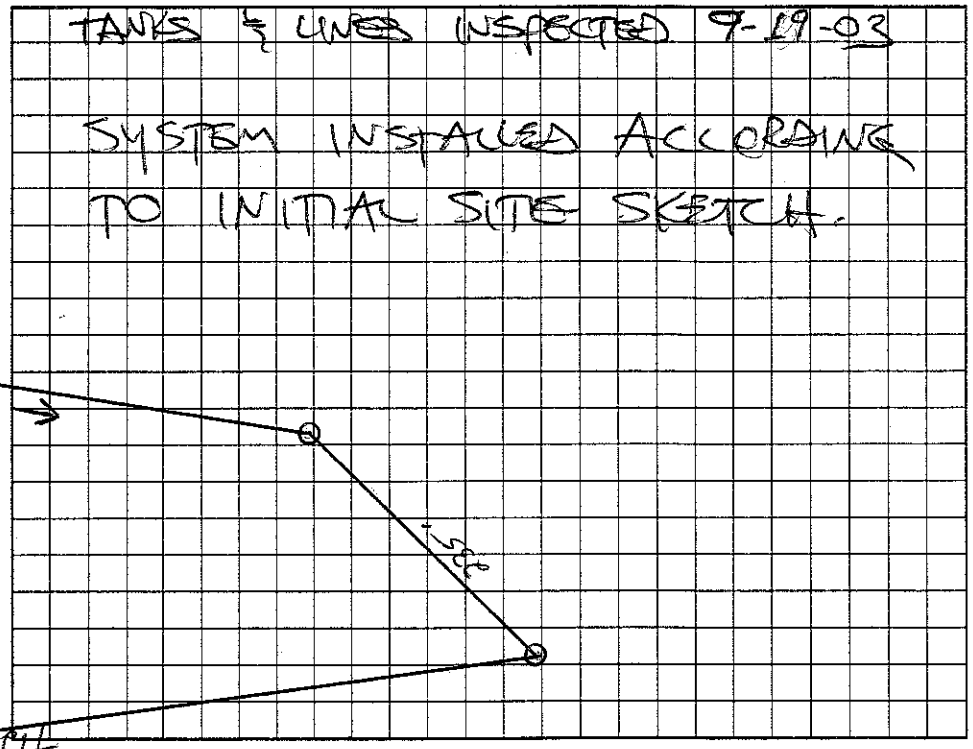

Permit can be suspended or revoked if any false information is supplied toward securing the permit/any unauthorized changes are made to the site/any unauthorized changes are made in the installation of the system. Improvement Permit with plat valid without expiration. Improvement Permit with site plan valid for sixty months. Authorization to Construct is valid for a period equal to that of Improvement Permit – not to exceed sixty months.

Signed: Sandy Bell date 1-6-03 Installed by: A-1 BACKHOE

Improvement Permit by: [signature] date 1-2-03 Operation Permit by: STEVE HENDRICK date 10-17-03

Authorization to Construct by: [signature] date 1-2-03 Existing System Inspection by: _____ date _____

HEALTH DEPT. COPY: WHITE OWNER COPY (FINAL): YELLOW OWNER COPY (INITIAL): PINK