IREDELL COUNTY HEALTH DEPARTMENT

Statesville Office (704) 878-5305 Mooresville Office (704) 660-3625 PERMIT # 176528

IMPROVEMENT PERMIT / AUTHORIZATION TO CONSTRUCT / OPERATION PERMIT / EXISTING SYSTEM

PIN # 4774196529

APPLICANT: Kris Meredith APPLICANT ADDRESS: 303 New Salem Rd, Statesville, NC 28625

SITE ADDRESS: 303 New Salem PHONE: 704 880 4719 ALT. PHONE:

SITE DIRECTIONS: Hwy 64 E to New Salem Church Rd, 2nd House on Left

SUBDIVISION: n/a SECTION: n/a LOT # n/a LOT AREA: 2.543 DESIGN FLOW: 240 L.T.A.R.: Ex

Septic Tank 1000 (gal) STB 760 Date 7-8-12
Pump Tank (gal) PT Date
Pump Make Model Serial #
Nitrification Fields Ex # Lines Ex Linear Ft: Ex
Trench Width Ex Max. Trench Bottom Depth Ex Gravel Depth Ex.


☐ New System ☒ Repair ☐ Expansion System Type: I (II) III IV V VI
System Description: 4
Repair System Description: TANK
Maintenance Agreement Required: ☐ YES ☒ NO
☒ GRAVITY ☐ PRESSURE

☒ Residence No. Bedrooms 2
☐ Business No. Persons
☐ Other No. Employees
☐ Slab ☒ Crawl Space
☐ Basement w/plumbing ☐ Basement w/o plumbing

Water Supply
☐ Private
☒ Public
☐ Community

Comments / Conditions:

INITIAL SITE SKETCH

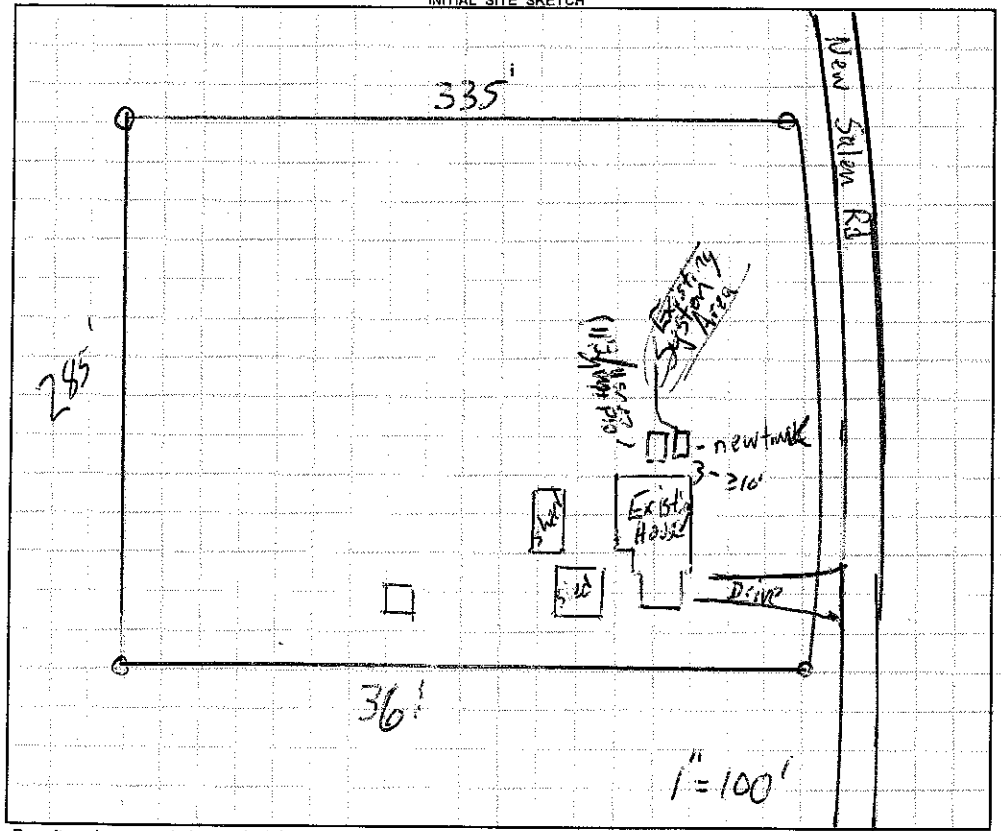

AS BUILT SKETCH

Permit can be suspended or revoked if any false information is supplied toward securing the permit / any unauthorized changes are made to the site / any unauthorized changes are made in the installation of the system. **CONTACT A LOCATOR SERVICE PRIOR TO ANY EXCAVATION**

☐ **IMPROVEMENT PERMIT** ***with plat*** *valid without expiration.* ☒ **IMPROVEMENT PERMIT** ***with site plan*** *valid for 60 mos.* ☒ **AUTHORIZATION TO CONSTRUCT** *valid for period equal to IMPROVEMENT PERMIT--not to exceed 60 mo.*

Owner / Applicant Signature: Kris Meredith Date: 1-8-13 Installed by: Jared Lentz

IMPROVEMENT PERMIT by: Date: 1-7-13 OPERATION PERMIT by: Date: 1-10-13

AUTHORIZATION TO CONSTRUCT by: Date: 1-7-13 Existing System Inspected by: Date:

Health Dept. Copy - WHITE Applicant (Final Approval) - YELLOW Applicant (Conditional Approval) - PINK