IREDELL COUNTY HEALTH DEPARTMENT

STATESVILLE 704-878-5305 MOORESVILLE 704-664-5281

IMPROVEMENT PERMIT / AUTHORIZATION TO CONSTRUCT / OPERATION PERMIT / EXISTING SYSTEM INSPECTION

PERMIT# 116429 PIN# 4774-19-7119 DATE 11-14-03

OWNER OR CONTRACTOR WAYNE HOMES MID ATLANTIC, LLC PHONE: Business 704-872-0271 x17 Home 704-872-8989

ADDRESS 130 VICTORY LANE, STATESVILLE, NC 28625

LOCATION US 64 EAST TRL NEW SALEM ROAD, TL SALEM MEADOWS DRIVE, 2ND LOT ON RIGHT

SUBDIVISION SALEM MEADOWS BLOCK / SECTION ____ LOT 23 LOT AREA 0.5165 ACRE SITE CLASS. PS DESIGN FLOW 480 L.T.A.R. 0.20 GPD/FT2

Septic Tank: 1000 Gallons; STB 312 Date 10-5-03
Pump Tank: ____ Gallons; PT ____ Date ____
Pump Make: ____ Model ____ Serial No. ____
Nitrification Field: No Fields 1 Square Feet EST 1800 Linear Feet 460
No Lines FOUR Trench Width 36" Max Trench Bottom Depth 36" Gravel Depth N/A

☑ New System ☐ Repair System Type: I, II, III, IV, V, VI
System Description: 25% REDUCTION, GRAVITY
Repair System Description: 50% REDUCTION, LOW PRESSURE
Maintenance Agreement Required: ☐ Yes ☑ No


☑ House/Mod. Home No. Bedrooms 3
☐ Mobile Home No. Bathrooms 2
☐ Business No. Employees ____
☐ Other ____
☐ Slab ☑ Crawl Space ☐ Basement w/plumbing ☐ Basement wo/plumbing

Water Supply: ☐ Individual ☑ Public ☐ Community

Comments:/Conditions: INSTALL 25% REDUCTION SYSTEM IN FOUR EQUAL LENGTH LINES ON CONTOUR AS SHOWN.

Comments:/Conditions: SEPTIC TANK WITH MARKER INSTALLED USING "ZABEL" FILTER

INITIAL SITE SKETCH SCALE: 1"=50'

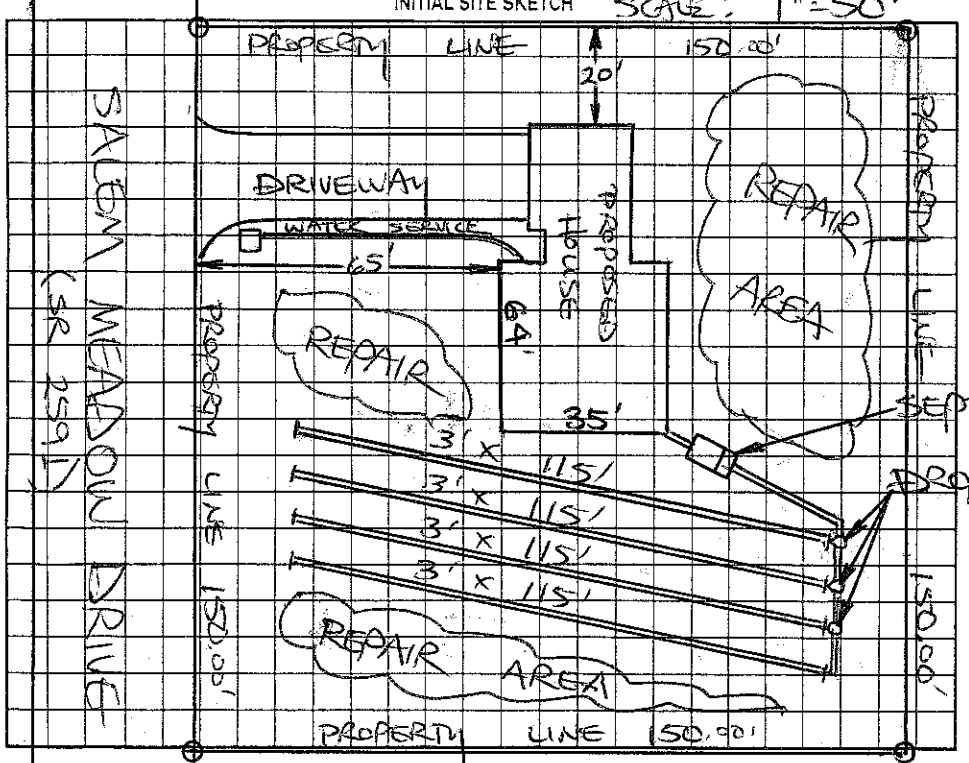

AS BUILT SKETCH

SYSTEM INSTALLED ACCORDING TO INITIAL SITE SKETCH

Permit can be suspended or revoked if any false information is supplied toward securing the permit/any unauthorized changes are made to the site/any unauthorized changes are made in the installation of the system. Improvement Permit with plat valid without expiration. Improvement Permit with site plan valid for sixty months. Authorization to Construct is valid for a period equal to that of Improvement Permit – not to exceed sixty months.

Signed: [signature] date 11-17-03 Installed by: TUCKERS HAULING & GRADING

Improvement Permit by: STEVE HEDRICK date 11-14-03 Operation Permit by: STEVE HEDRICK date 12-29-03

Authorization to Construct by: STEVE HEDRICK date 11-14-03 Existing System Inspection by: ____ date ____

HEALTH DEPT. COPY: WHITE OWNER COPY (FINAL): YELLOW OWNER COPY (INITIAL): PINK