IREDELL COUNTY HEALTH DEPARTMENT

STATESVILLE 704-878-5305 MOORESVILLE 704-664-5281

4:00 52489

IMPROVEMENT PERMIT / CERTIFICATE OF COMPLETION / OPERATION PERMIT / EXISTING SYSTEM INSPECTION

PROPERTY DESCRIPTION NO. 18619 DATE 10-7-94 TAX MAP NO. 5R-2-A-3 Watershed: ☐ Yes ☑ No

OWNER OR CONTRACTOR Tim Hamby PHONE: Business Home 872-0825

ADDRESS 906 old mocksville Rd Ste

LOCATION Hwy 64 E TR New Salem Rd TL Salem meadows 3rd lot left

SUBDIVISION Salem meadows BLOCK / SECTION LOT 3 LOT AREA approx 1 acre SITE CLASS. PJ DESIGN FLOW 360 L.T.A.R. .28

Septic Tank: 1000 Gallons; STB 794 Date 6-27-94

Pump Tank: Gallons; PT Date

Pump Make: Model Serial No.

Nitrification Field: No Fields 1 Square Feet 1350 Linear Feet 450

No Lines 4 Trench Width 36" Max Trench Bottom Depth 24" Gravel Depth 12"

☐ New System ☐ Repair System Type: I, II, III, IV, V, VI

System Description:

Repair System Description:

Maintenance Agreement Required: ☐ Yes ☐ No

☐ House/Mod. Home No. Bedrooms

☐ Mobile Home No. Bathrooms

☐ Business No. Employees

☐ Other

☐ Slab ☑ Crawl Space ☐ Basement w/plumbing ☐ Basement wo/plumbing


Water Supply: ☐ Individual ☐ Community ☐ Public

Comments: An Interceptor Drain may be required if it determined it needs one.


Replaces Permit issued 6-7-94

Comments:

INITIAL SITE SKETCH

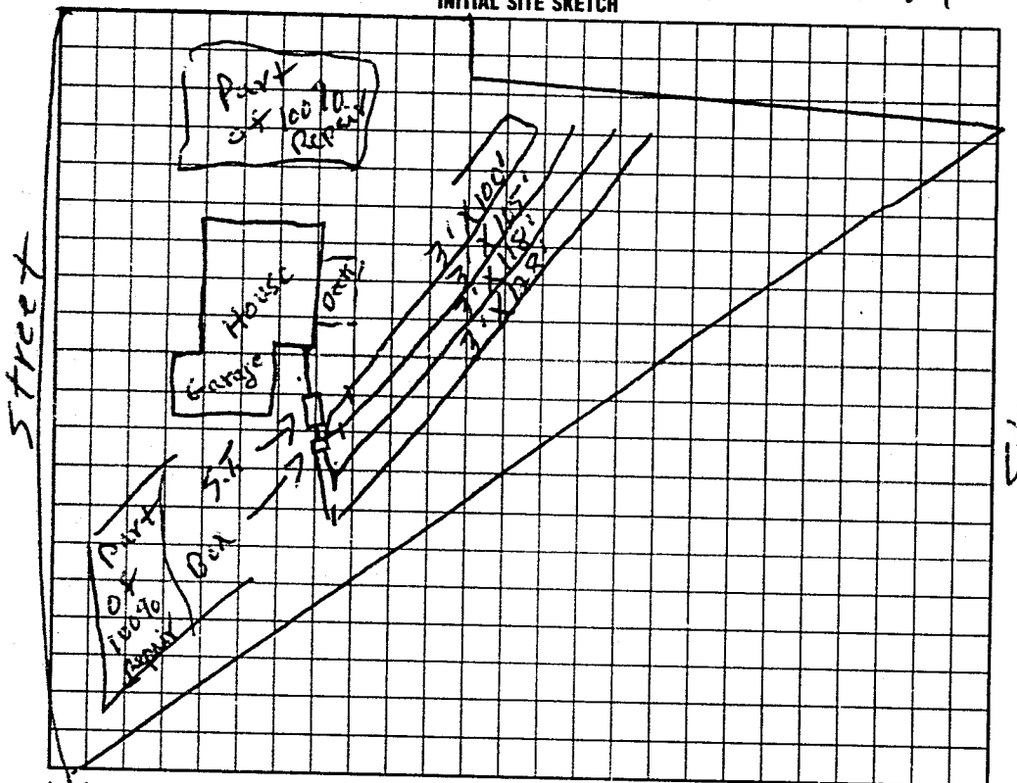

AS BUILT SKETCH

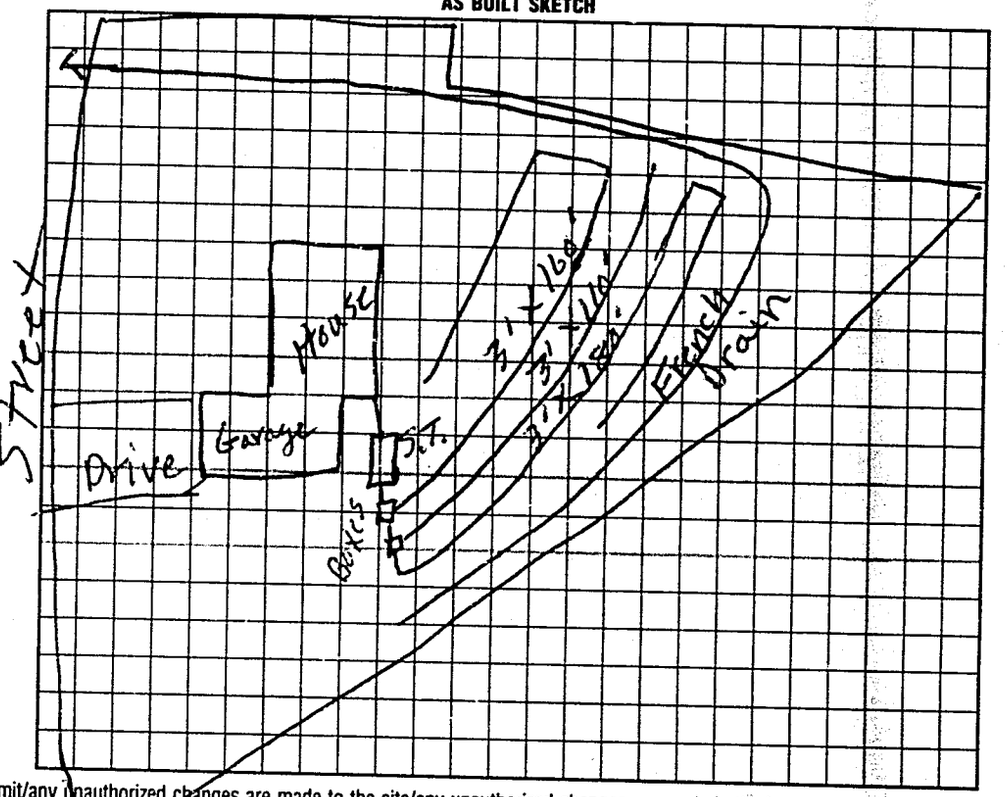

I understand that this permit can be suspended or revoked if any false information is supplied toward securing the permit/any unauthorized changes are made to the site/any unauthorized changes are made in the installation of the system. Improvement Permit is valid for 60 months from date of issuance.

Signed: x Ben Jenkins

Improvement Permit by: L. C. Moore date 10-7-94

Existing System Inspection by: date

Installed by: A-1 Backhoe

Certificate of Completion by: L. C. Moore date 12-12-94

Operation Permit by: date

HEALTH DEPT. COPY: WHITE INSPECTION COPY (FINAL): GREEN OWNER COPY (FINAL): YELLOW INSPECTION COPY (INITIAL): PINK OWNER COPY (INITIAL): GOLD